

NOTE:
1. MOST OF THE UTILITY INFORMATION PROVIDED
ON THIS PLAN IS PER RECORD MAPS FROM
RGE AND PURE WATERS. CONTRACTOR TO
COORDINATE IN FIELD BEFORE START CONSTRUCTION.

Dig Safely.
New York

800-962-7962

www.digsafelynewyork.org


Call Before You Dig

Wait The Required Time

Confirm Utility Response

Respect the Marks

Dig With Care

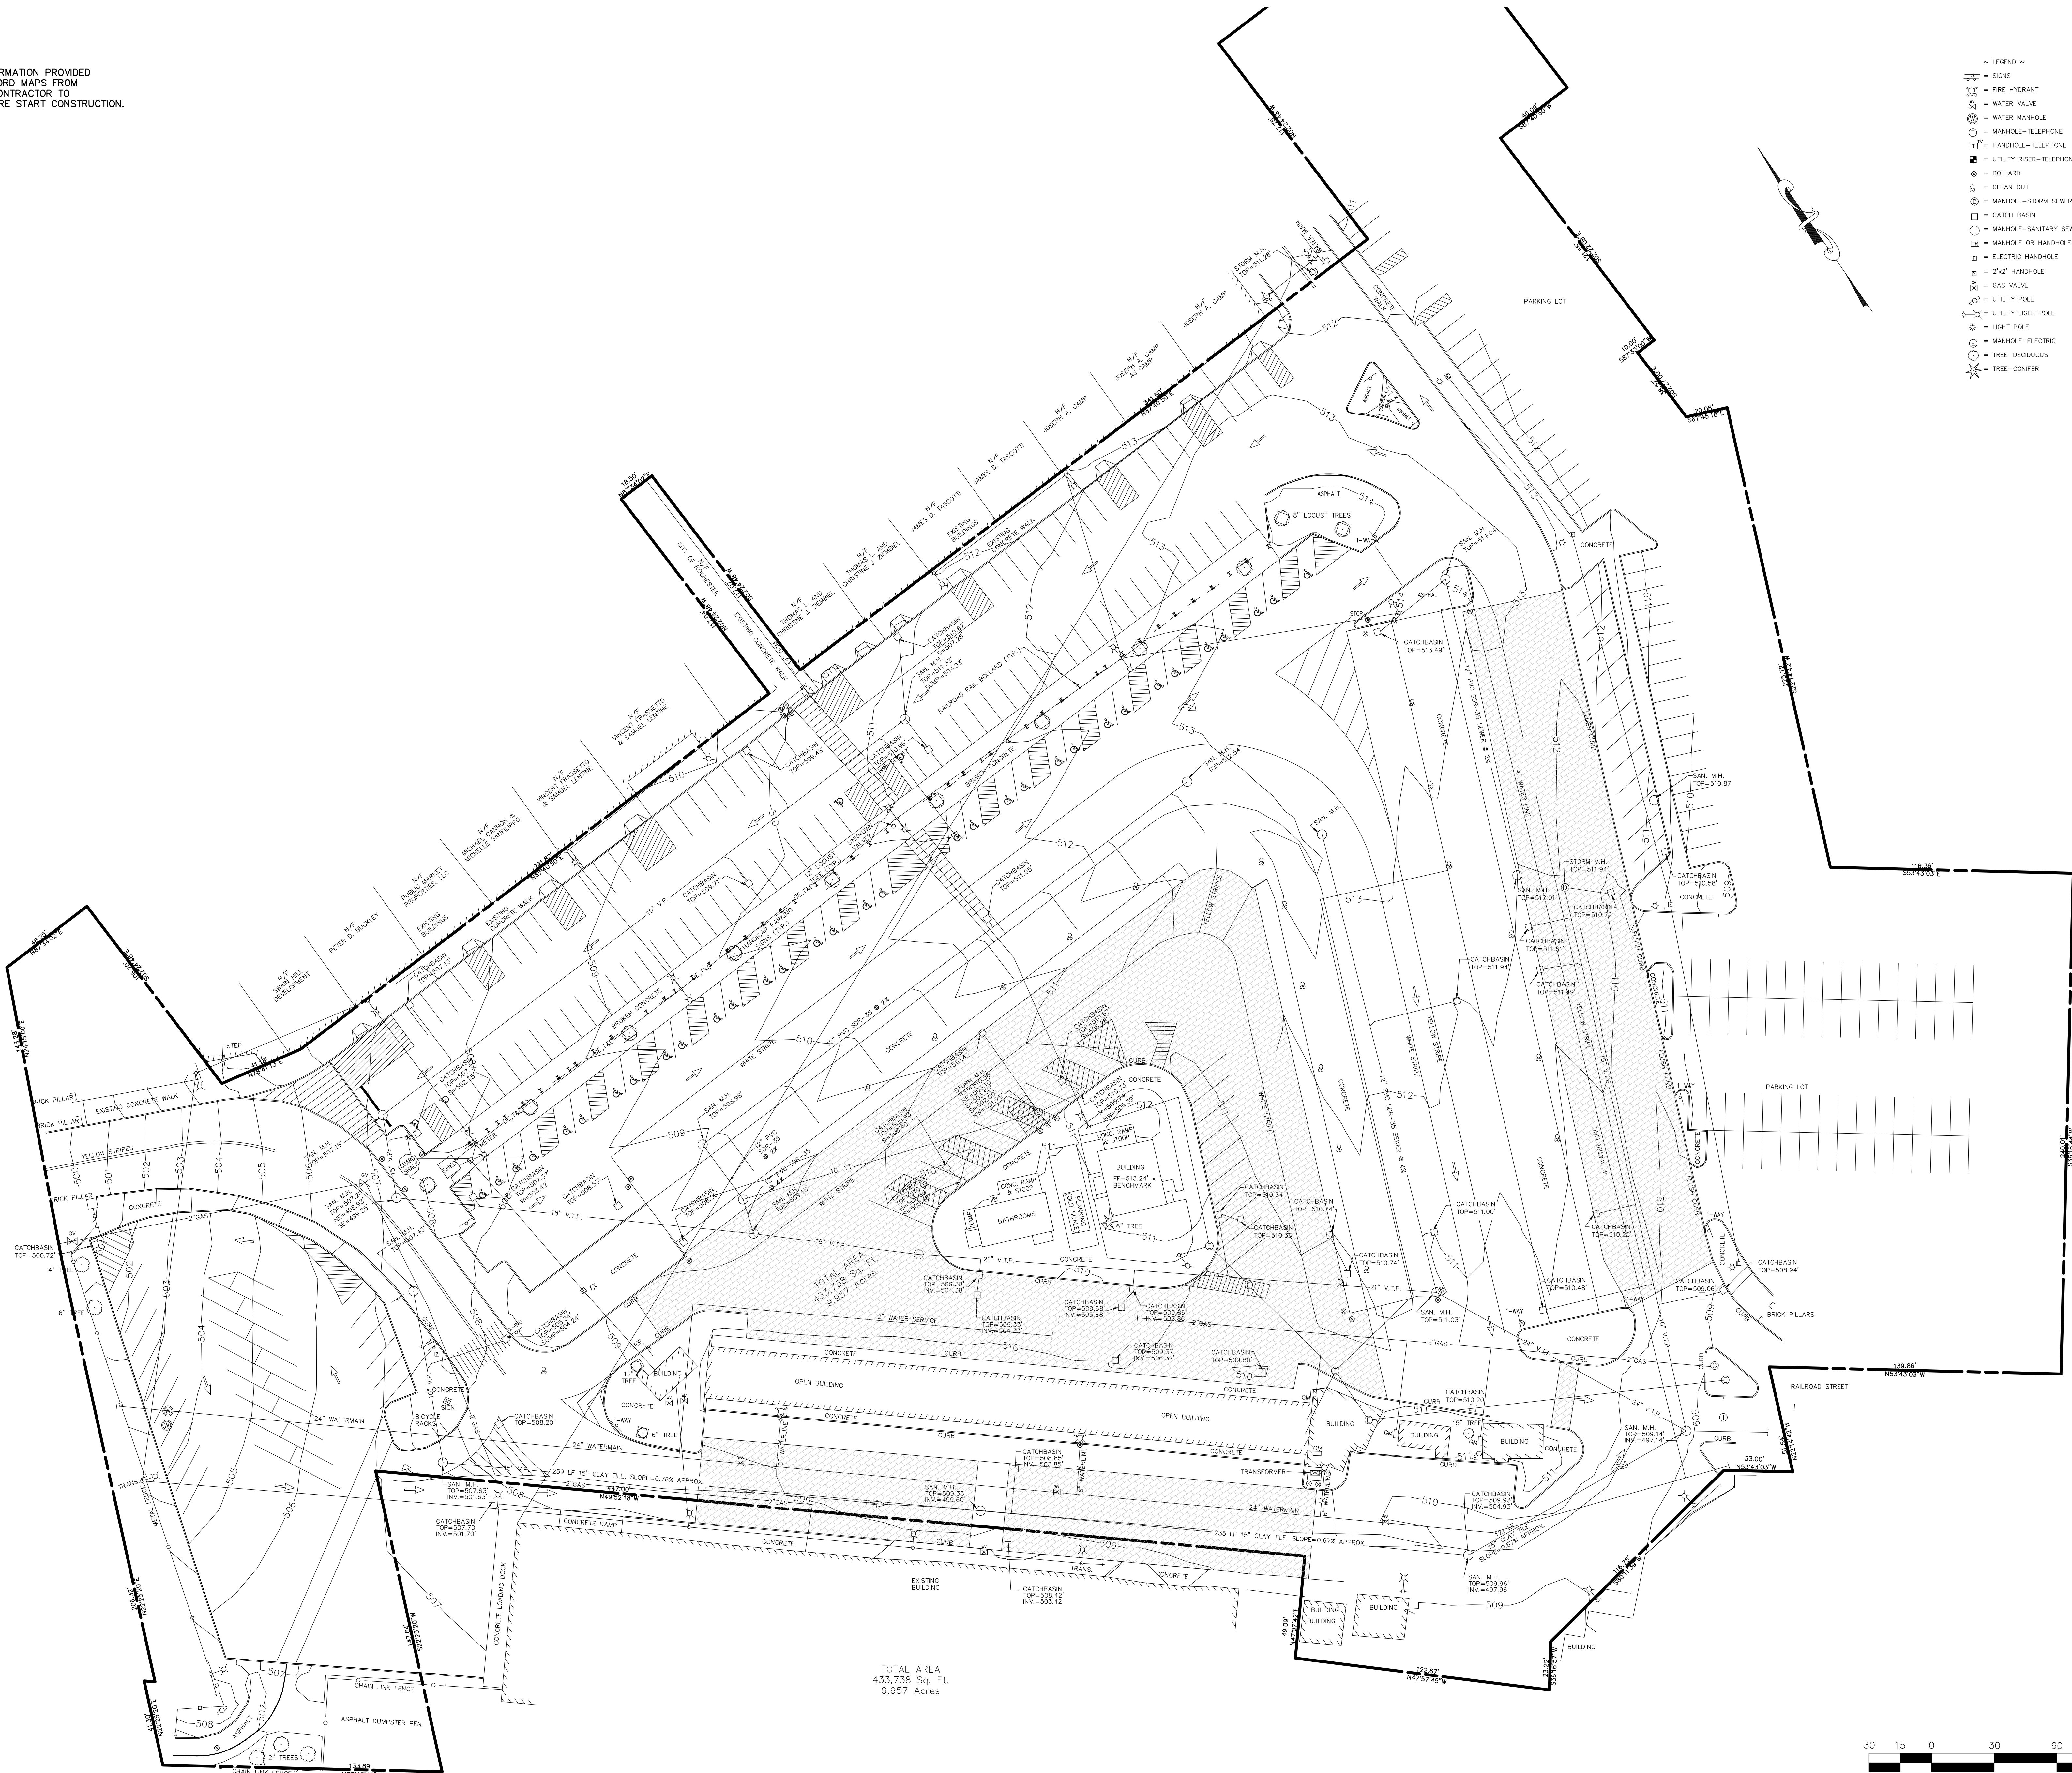

- LEGEND
- SIGNS
 - FIRE HYDRANT
 - WATER VALVE
 - MANHOLE
 - MANHOLE-TELEPHONE
 - UTILITY RISER-TELEPHONE
 - BOLLARD
 - CLEAN OUT
 - MANHOLE-STORM SEWER
 - CATCH BASIN
 - MANHOLE-SANITARY SEWER
 - MANHOLE OR HANDHOLE-TRAFFIC
 - ELECTRIC HANDHOLE
 - 2"x2" HANDHOLE
 - GAS VALVE
 - UTILITY POLE
 - UTILITY LIGHT POLE
 - LIGHT POLE
 - MANHOLE-ELECTRIC
 - TREE-DECIDUOUS
 - TREE-CONIFER

AS-BUILT DRAWINGS

DATE: 05/16/18
DRAWN BY: JVC
CHECKED BY: JVC
PROJECT NO.: 435346.01
SHEET NO.: 5

05/16/18
DATE

TYLINT INTERNATIONAL


255 EAST AVENUE
ROCHESTER, NY 14604
(585) 512-2000

DRAWING TITLE: TOPOGRAPHIC SURVEY
PROJECT NO.: 435346.01
PROJECT NAME: SHED D AND TEMPORARY KIOSK LOCATIONS
CLIENT: ROCHESTER PUBLIC MARKET
30 Church Street, Rochester, NY 14614

PROJECT NO.: 435346.01	PROJ. MGR.: THC
DATE: 5/16/18	DRAWN BY: JVC
SCALE: 1"=30'	CHECKED BY: RLB
DRAWING NO.: DC101	
SHEET NO.: 5	of 73

1. BUILDING AND APPURTENANCES DESIGNATED FOR DEMOLITION SHALL NOT BE DISTURBED BY THE CONTRACTOR UNTIL THE OWNER HAS BEEN GIVEN NOTICE OF POSSESSION AND APPROVAL TO PROCEED BY THE OWNER.
2. THE CONTRACTOR SHALL COORDINATE THE SCHEDULE WITH OWNER AND ADJACENT PROPERTY OWNERS AND THE CITY ENGINEER. THE WORK SHALL BE UNDER THE DIRECTION OF THE OWNER AND CONSTRUCTION MANAGER.
3. FILL SHALL BE TESTED IN ACCORDANCE WITH THE SPECIFICATIONS FOR TRENCH BACKFILL. STRUCTURAL FILL TO CONSIST OF SUITABLE ON-SITE OR IMPORTED MATERIALS AT LEAST 95% OF MODIFIED PROCTOR MAXIMUM DENSITY DETERMINED BY THE ASTM -D1557 PROCEDURE, AND MEETING THE NYSDOT SPECIFICATION 203-2.02 TYPE C. SELECT STRUCTURAL FILL.
4. ALL REMOVED MATERIAL, EXCEPT THAT BELONGING TO A PUBLIC OR PRIVATE UTILITY COMPANY, SHALL BECOME THE PROPERTY OF THE CONTRACTOR. THE CONTRACTOR SHALL ADVISE THE OWNERS OF WATER, ELECTRIC, OR GAS METERS WHEN THE METERS ARE READY FOR REMOVAL AND SHALL BE RESPONSIBLE FOR THE REMOVAL OF THE METERS IN ACCORDANCE WITH LOCAL REQUIREMENTS. DISCONNECT ELECTRIC TRANSFORMERS AS REQUIRED FOR BUILDING DEMOLITION.
5. THE CONTRACTOR IS SOLELY RESPONSIBLE FOR ANY DAMAGE TO EXISTING UTILITIES THAT ARE INTENDED TO REMAIN TO PROVIDE SERVICE WHETHER SHOWN ON THE PLANS OR NOT.
6. CONTRACTOR TO VERIFY THAT ELECTRIC CONDUITS/CABLES AND GAS LATERALS HAVE BEEN UNBUNDLED PRIOR TO EXCAVATION.
7. EXISTING TOP AND UTILITY LOCATIONS ARE BASED ON THE INFORMATION PROVIDED. THE CONTRACTOR IS SOLELY RESPONSIBLE FOR VERIFYING ALL EXISTING UTILITY LOCATIONS WHETHER SHOWN ON THESE PLANS OR NOT.
8. PRIOR TO INITIATING DEMOLITION WORK THE CONTRACTOR SHALL PROVIDE A RATION OF ALL EXISTING STRUCTURES AND SURROUNDING PROPERTIES. THE RECORD SHALL INCLUDE CONDITIONS OF EXISTING STREET AND ADJACENT PROPERTIES. THE RECORD SHALL BE MADE AVAILABLE UPON REQUEST.
9. RECYCLED CONCRETE AND ASPHALT DERIS MAY BE UTILIZED FOR FILL MATERIALS AT AREAS 10' OUTSIDE THE BUILDING PAD AREA ONLY AS APPROVED BY OWNER. THE FILL SHALL BE 100% RECYCLED CONCRETE OR 25% RECYCLED TO 75% NEW MATERIALS. ALL FILL MATERIAL UNDER BUILDING PAD AND SIDEWALKS SHALL BE 100% RECYCLED CONCRETE OR 25% RECYCLED TO 75% NEW MATERIALS. MIN. OF 10' BEYOND EDGE OF WORK. (SEE NOTE #3 FOR FILL.
10. CONTRACTOR TO SALVAGE EXISTING PAVED PAVERS THAT ARE REMOVED TO BE REUSED FOR NEW PAVEMENT AREAS.
11. ALL DERIS FROM DEMOLITION SHALL BE HAULED OFF-SITE AND DISPOSED OF BY LEGAL MEANS.
12. ALL TRENCHES WHERE CONDUITS AND/OR PIPES HAVE BEEN REMOVED SHALL BE BACKFILLED WITH NO. 2 SELECT STRUCTURAL FILL TO MEET THE UNMODIFIED PROCTOR DENSITY PER ASTM D-1557.

	EXIST. PAVEMENT AREA TO BE REMOVED
	EXISTING CONCRETE AREA TO BE REMOVED
-----	EXISTING FEATURE TO BE REMOVED
-----	LIMIT OF PAVEMENT REMOVAL
T.B.R.	TO BE REMOVED
T.R.	TO REMAIN
T.B.R.L.	TO BE RELOCATED

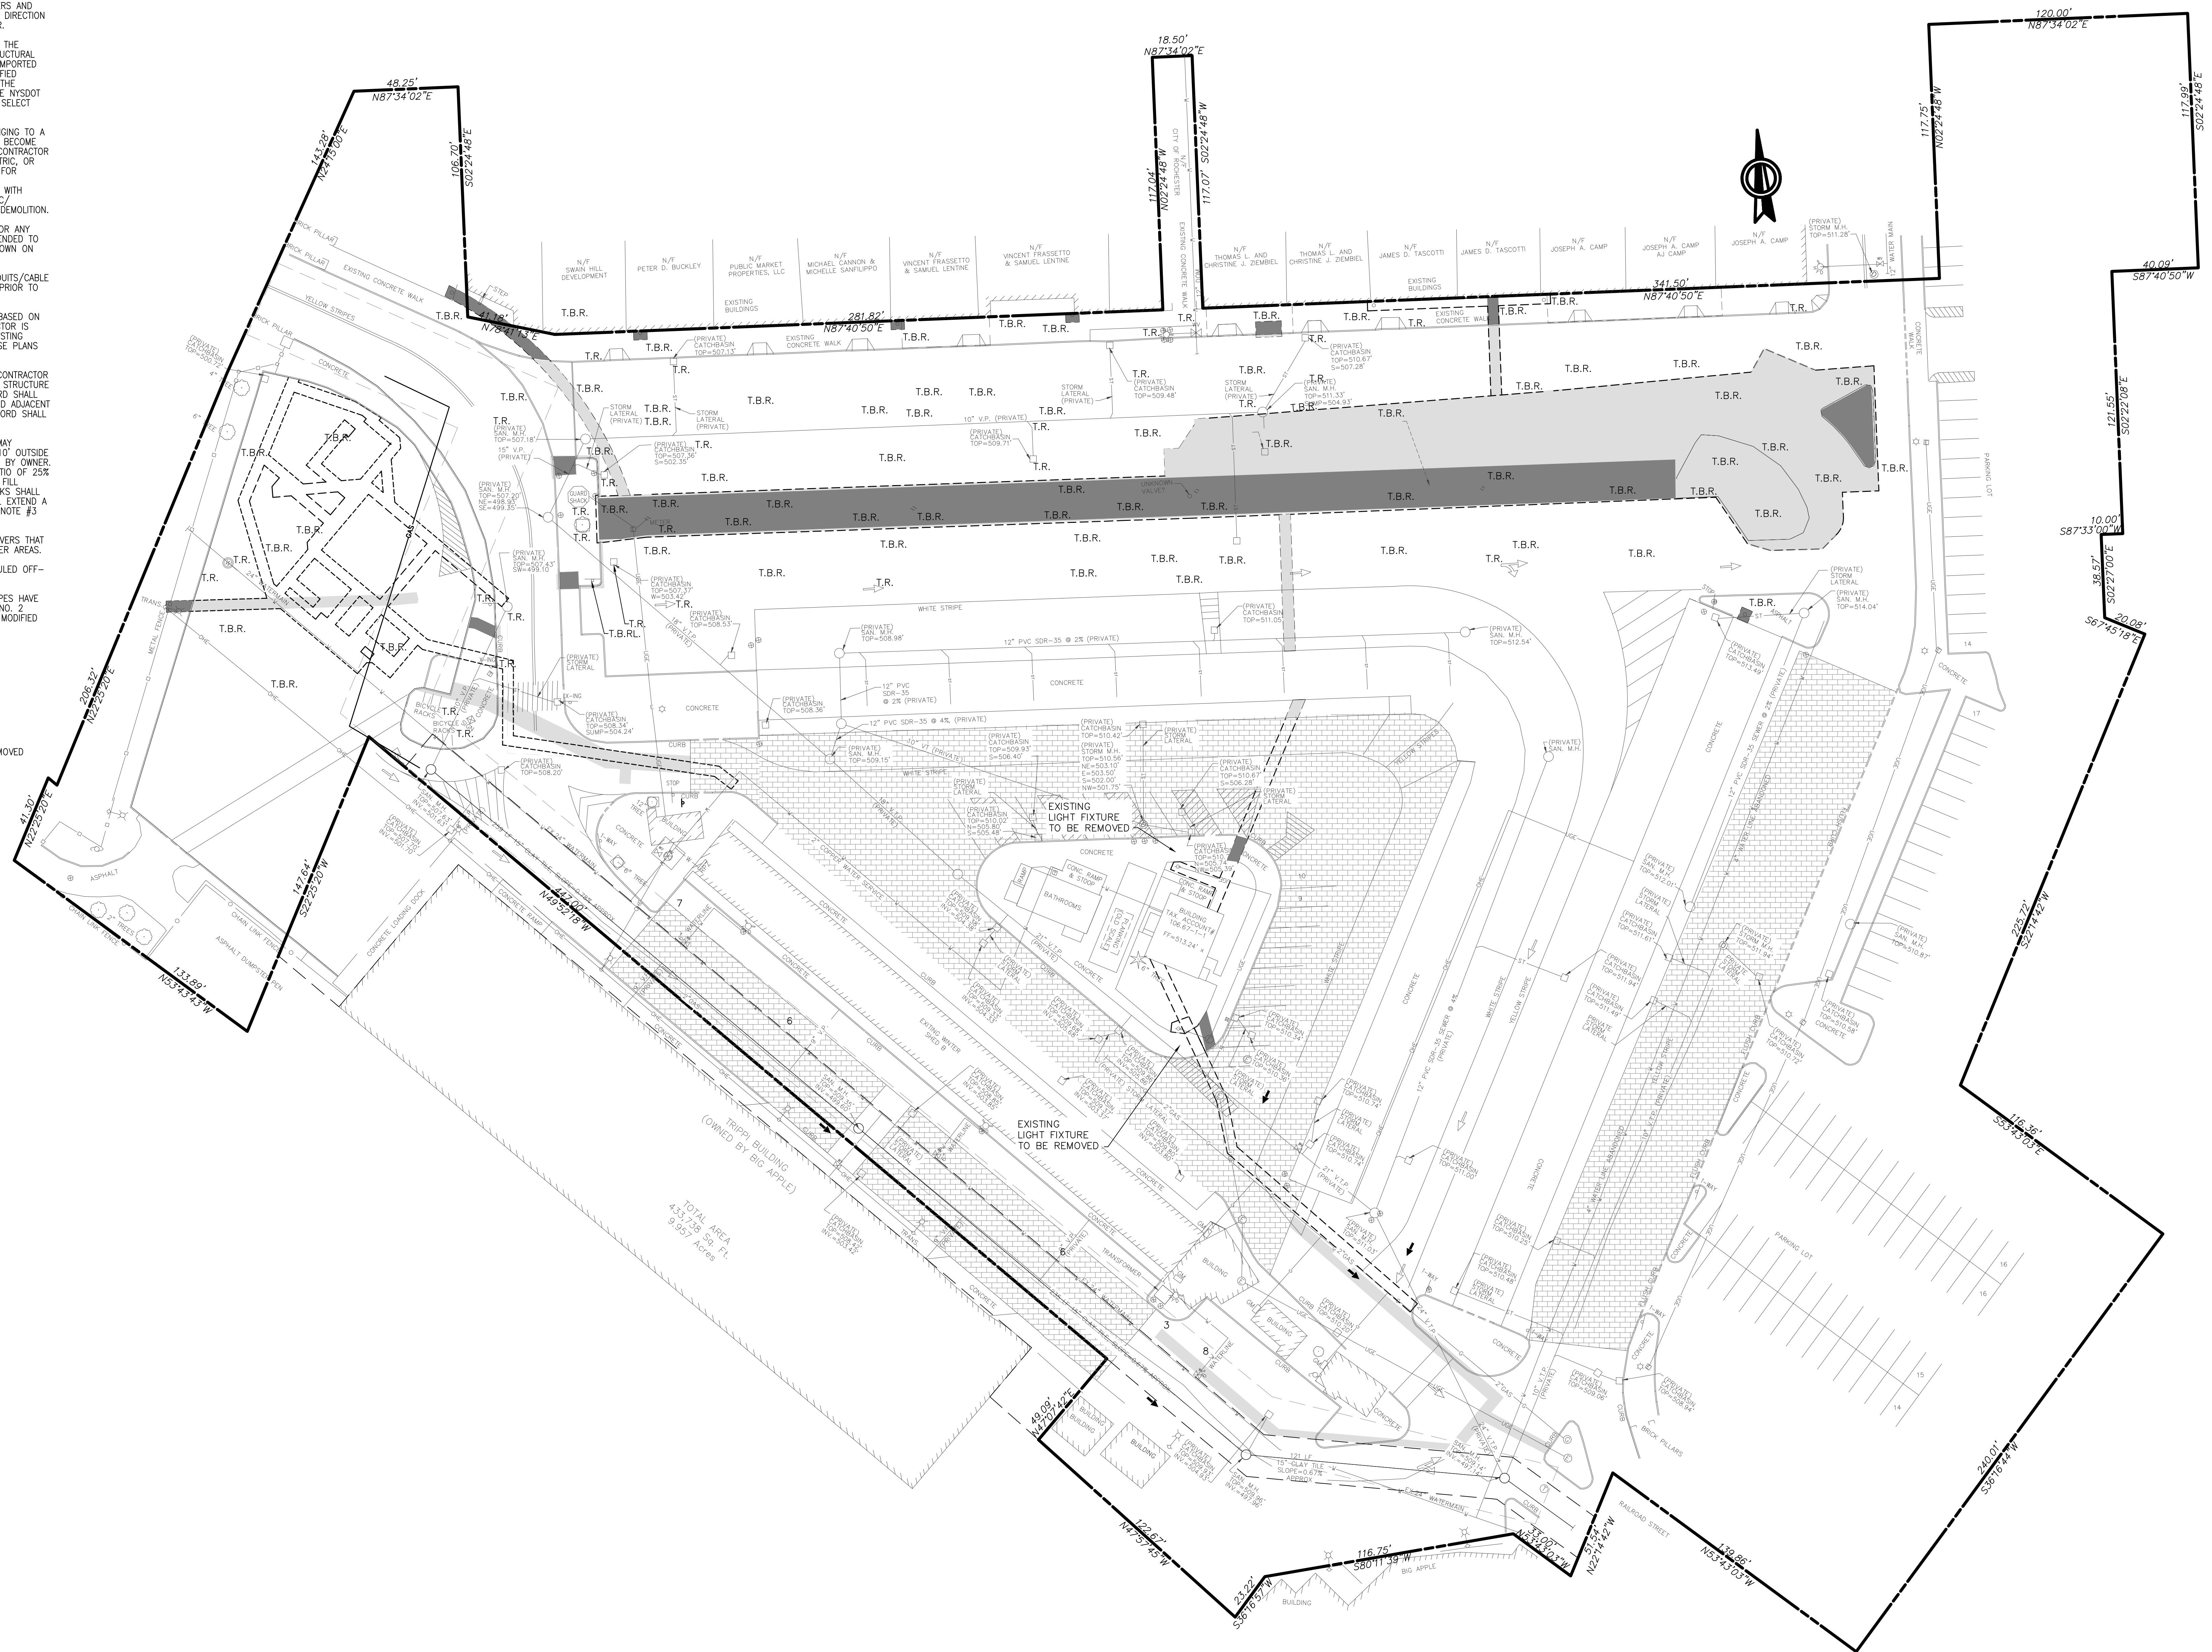

Dig Safely.
New York
800-962-7962
www.digsafelynewyork.org

- ☐ Call Before You Dig
- ☐ Wait The Required Time
- ☐ Confirm Utility Response
- ☐ Respect the Marks
- ☐ Dig With Care

AS-BUILT DRAWINGS

[illegible]

05/16/18
DATE

TY·LININTERNATIONAL

255 EAST AVENUE
ROCHESTER, NY 14604
(585) 512-2000

DRAWING TITLE: DEMOLITION PLAN
SHED D AND TEMPORARY KIOSK LOCATIONS

PROJECT NAME: ROCHESTER PUBLIC MARKET
280 Union Street N, Rochester, NY 14609

CLIENT: ROCHESTER PUBLIC MARKET
30 Church Street, Rochester, NY 14614

PROJECT NO.: 435346.01	PROJ. MGR.: THC
DATE: 5/16/18	DRWN. BY: JV
SCALE: 1"=30'	CHKD. BY: RLR

DRAWING NO:
DC102

SHEET NO.
6 of 73

A horizontal graphic scale bar divided into segments by vertical tick marks. The numbers 30, 15, 0, 30, 60, and 90 are placed above the corresponding tick marks. The segments alternate between white and black shading. Below the bar, the text "SCALE IN FEET" is centered.

ADA/STRIPING LEGEND	
(A1)	9' WIDE ACCESSIBLE SPACE @ MAX. 2.0% RUNNING SLOPE AND MAX. 2.0% CROSS SLOPE WITH SIGN AND SYMBOL PER ADA REQUIREMENTS
(A2)	9' WIDE ACCESSIBLE AISLE WITH 4" PAINTED "ADA BLUE" STRIPE @ 45°, 2' O.C. @ MAX. 2.0% RUNNING SLOPE AND MAX. 2.0% CROSS SLOPE
(A3)	4" WHITE PARKING STRIPE OR STRIPED AREA - 4" WHITE STRIPES @ 45°, 2' O.C.
(A4)	PAINTED PAVEMENT ARROW
(A5)	5' WIDE "WHITE" PEDESTRIAN CROSSING WITH 6" STRIPING PARALLEL TO TRAFFIC FLOW
CONCRETE PADS/ASPHALT PAVING	
(AP1)	NEW PAVEMENT AREA
(AP2)	LIMIT OF NEW PAVEMENT/MATCH EXISTING
CURBING/BOLLARDS/SIDEWALKS/RAMPS	
(C1)	6"x18" STONE CURB
(C2)	6" PROPOSED BOLLARD
(R#)	ACCESSIBLE SIDEWALK RAMP # (SEE DWG. D0201 FOR DETAILS)
BUSINESS / ACCESSIBLE SIGNS	
(S1)	"RESERVED PARKING" ACCESSIBLE SIGN
(S12)	"VAN ACCESSIBLE" SIGN
(S13)	"VIOLATION" SIGN
(S14)	"NO PARKING ANYTIME" SIGN, SIGNAGE BELOW 80" ABOVE FINISH GRADE


- SITE NOTES**
- CONTRACTOR SHALL REFER TO ARCHITECTURAL PLANS FOR PRECISE BUILDING DIMENSIONS.
 - COORDINATE START-UP AND ALL CONSTRUCTION ACTIVITIES WITH CITY OF ROCHESTER REPRESENTATIVE.
 - CONSTRUCTION METHODS AND OWNER'S MATERIALS NOT SPECIFIED IN THESE PLANS ARE TO MEET OR EXCEED CITY OF ROCHESTER STANDARD SPECIFICATIONS OR AS SPECIFIED BY THE CITY OF ROCHESTER REPRESENTATIVE.
 - THE CONTRACTOR SHALL CONDUCT THE WORK IN A MANNER THAT WILL INSURE, AS FAR AS PRACTICABLE, THE LEAST OBSTRUCTION TO TRAFFIC AND SHALL PROVIDE FOR THE CONVENIENCE AND SAFETY OF THE GENERAL PUBLIC IN AN ADEQUATE AND SATISFACTORY MANNER.
 - THE CONTRACTOR SHALL LOCATE, MARK, SAFEGUARD AND PRESERVE ALL SURVEY CONTROL MONUMENTS AND R.O.W. MONUMENTS IN THE AREAS OF CONSTRUCTION.
 - THE SITE WORK FOR THIS PROJECT SHALL MEET OR EXCEED THE CITY OF ROCHESTER STANDARD SITE WORK SPECIFICATIONS. ALL CURRENT ADDENDUMS.
 - ALL DIMENSIONS SHOWN ARE TO THE FACE OF THE CURB UNLESS OTHERWISE NOTED.
 - THE CONTRACTOR IS RESPONSIBLE TO ENSURE THAT ALL REQUIRED INSPECTIONS AND/OR CERTIFICATIONS REQUIRED BY CODES AND/OR THE JURISDICTIONAL AUTHORITY ARE COMPLETED.

PAVEMENT STRIPING SPECIFICATION

ALL ACCESSIBLE STRIPING SHALL BE "ADA" BLUE, INCLUDING THE OUTER LINE OF THE ACCESSIBLE SPACE. AN INITIAL PRIMER COAT OF WHITE SHALL BE USED PRIOR TO PAINTING OF THE BLUE LINES.


LEGEND	
	PROPOSED CONCRETE SIDEWALK/PAD
	PROPOSED MEDIUM DUTY ASPHALT SECTION

SUMMARY OF PARKING	
EXISTING NON ADA:	231 SPACES
PROPOSED NON ADA:	235 SPACES
NET CHANGE IN PARKING:	+4 SPACES
EXISTING ADA:	47 SPACES
PROPOSED ADA:	39 SPACES
NET CHANGE IN PARKING:	-8 SPACES

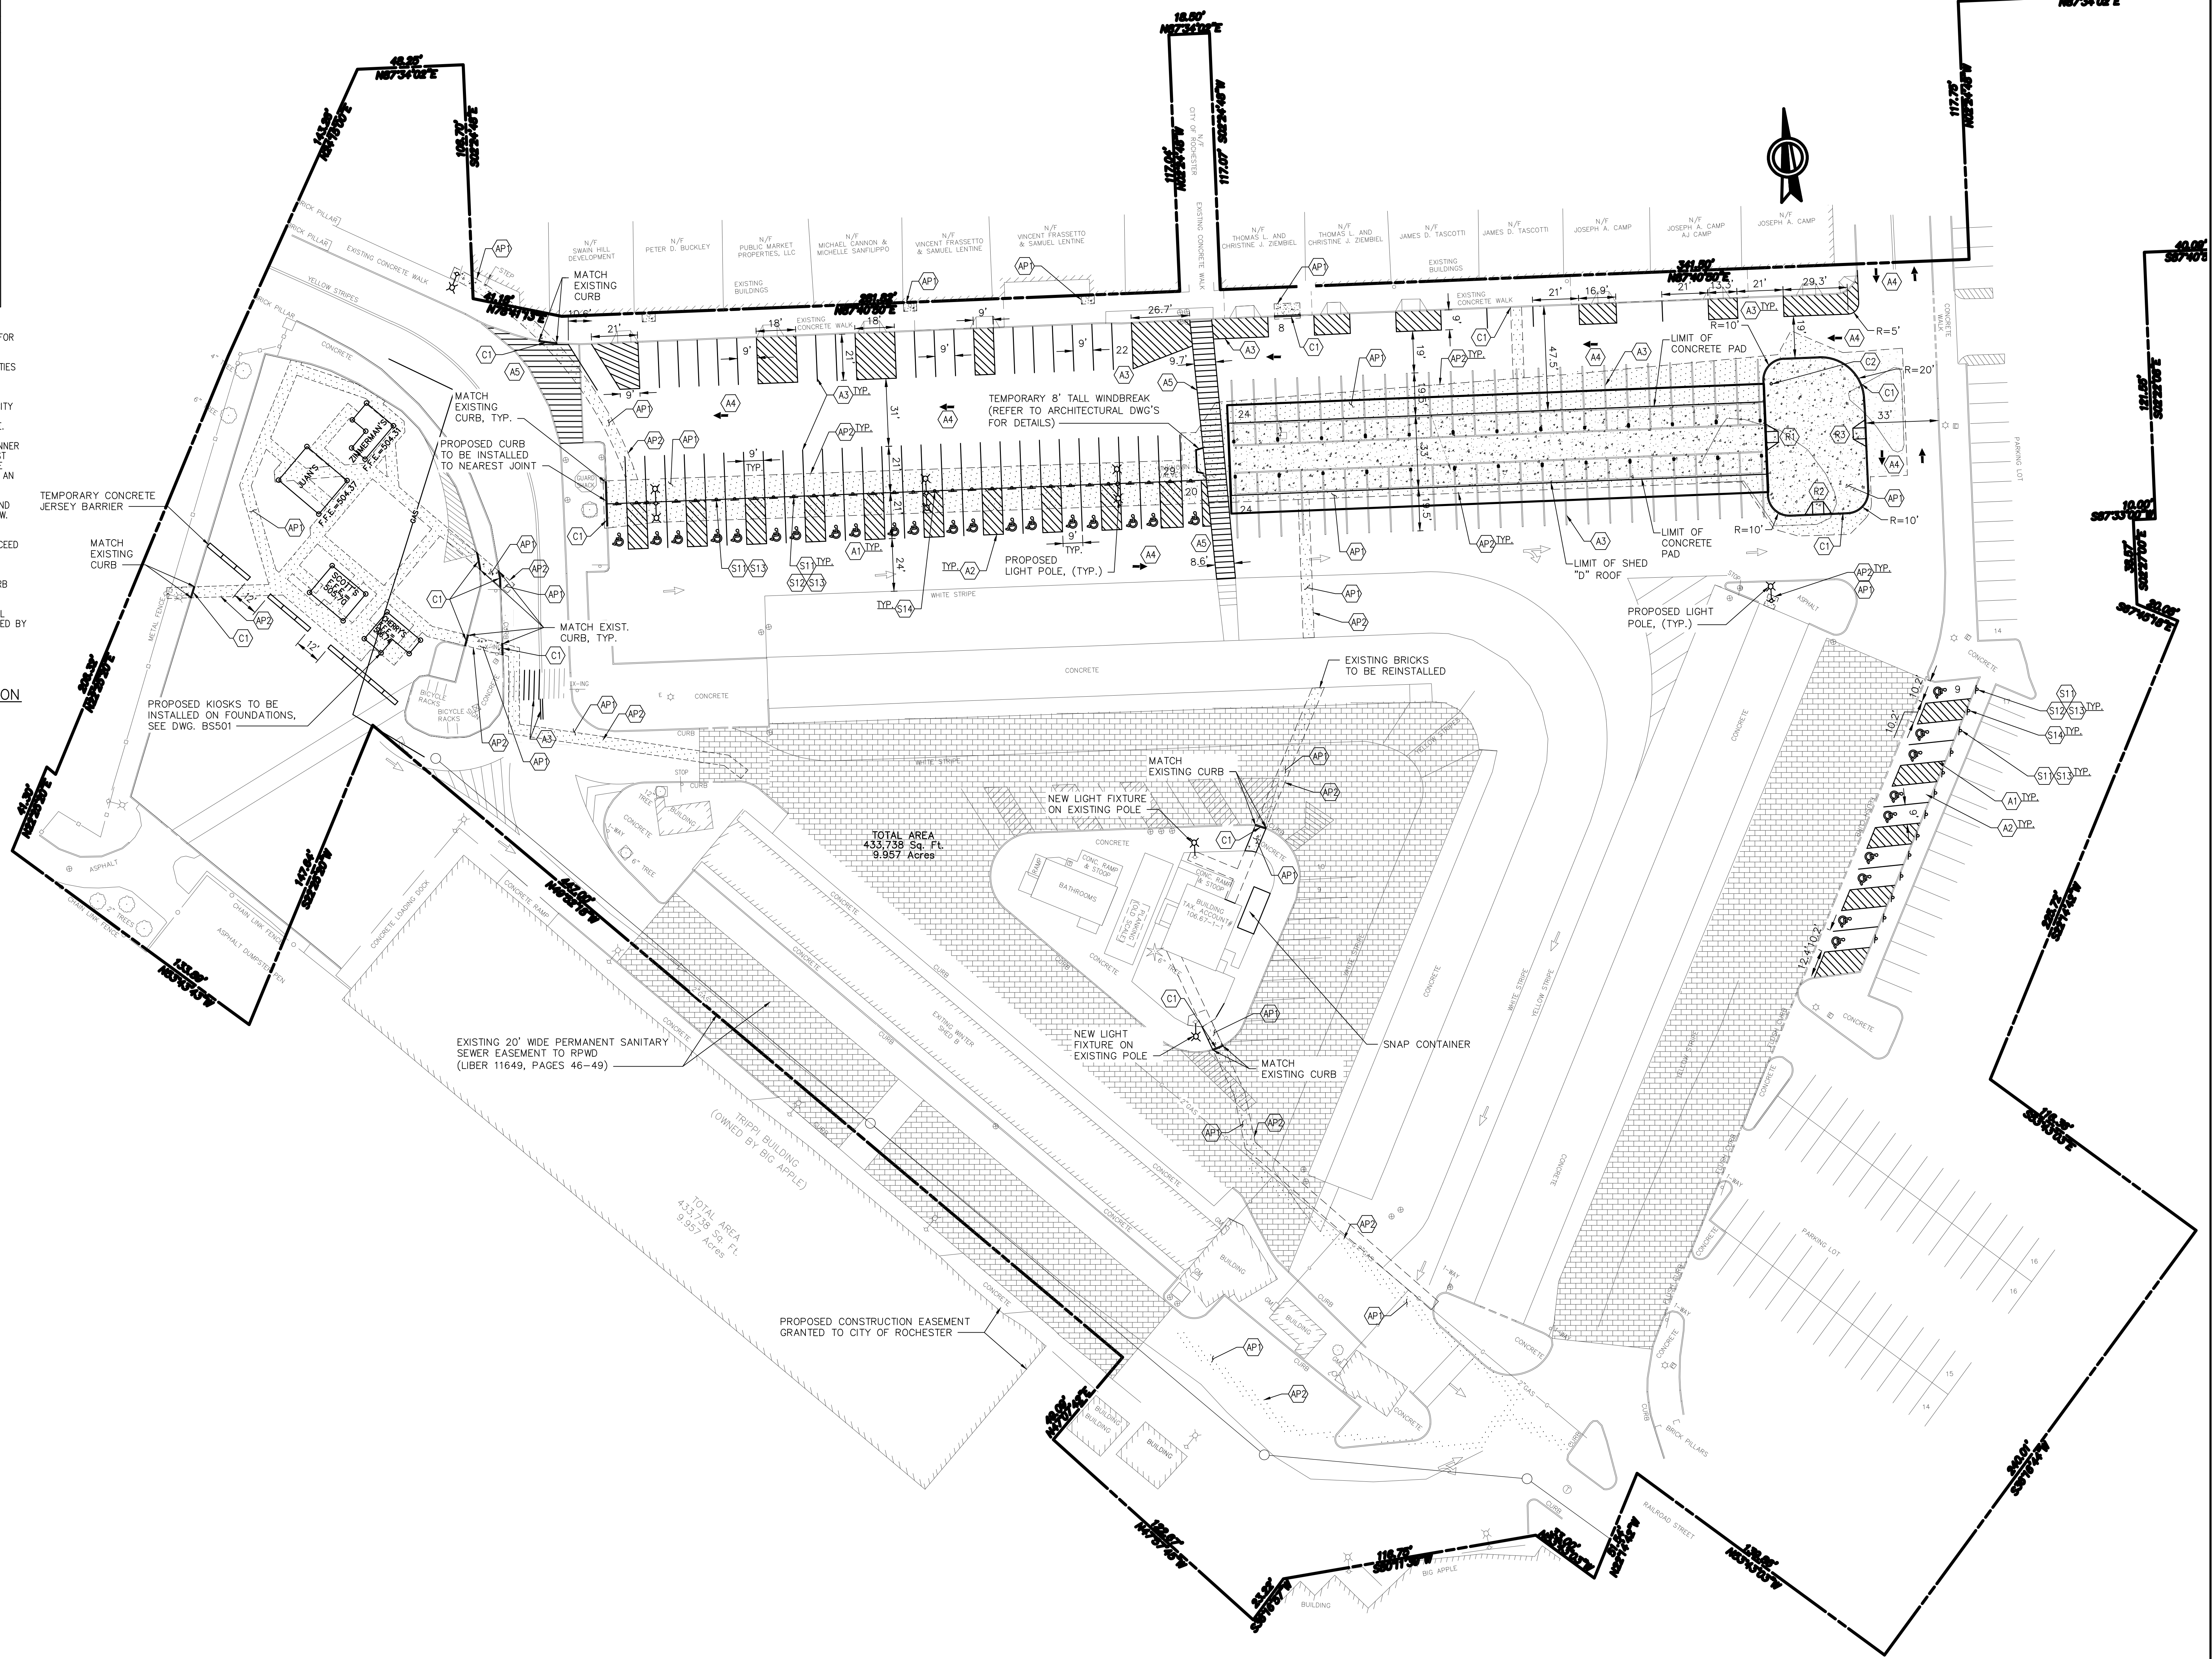

Dig Safely.
New York
800-962-7962
www.digsafelynewyork.org

- ☐ Call Before You Dig
- ☐ Wait The Required Time
- ☐ Confirm Utility Response
- ☐ Respect the Marks
- ☐ Dig With Care

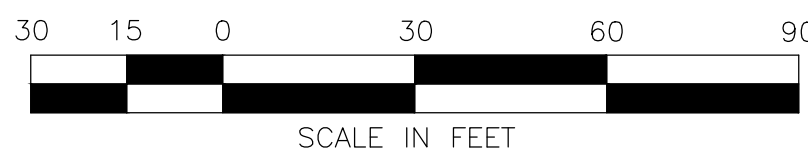

AS-BUILT DRAWINGS

REVISIONS	
NO.	DATE
2	
1	

05/16/18
DATE

TYLININTERNATIONAL

255 EAST AVENUE
ROCHESTER, NY 14604
(585) 512-2000

SITE PLAN
SHED D AND TEMPORARY KIOSK LOCATIONS
ROCHESTER PUBLIC MARKET
280 Union Street N, Rochester, NY 14609
CLIENT: ROCHESTER PUBLIC MARKET
30 Church Street, Rochester, NY 14614

PROJECT NO.:	435346.01
PROJ. MGR.	THC
DATE:	5/16/18
DRWN. BY:	JV
SCALE:	1"=30'
CHKD. BY:	RLB
DRAWING NO.	DC103
SHEET NO.	7 of 73


- GRADING NOTES**
1. GRADING SHALL BE KEPT WITHIN THE LIMITS SHOWN ON THE GRADING PLAN. CONTRACTOR SHALL PROTECT EXISTING TREES AND VEGETATION OUTSIDE THE LIMITS OF GRADING.
 2. THE CONTRACTOR IS SPECIFICALLY CAUTIONED THAT THE LOCATION AND/OR ELEVATIONS OF EXISTING UTILITIES AS SHOWN ON THESE PLANS IS BASED ON RECORDS OF THE VARIOUS UTILITY COMPANIES AND, WHERE POSSIBLE, MEASUREMENTS TAKEN IN THE FIELD. THE INFORMATION IS NOT TO BE RELIED ON AS BEING EXACT OR COMPLETE.
 3. THE CONTRACTOR MUST CALL THE APPROPRIATE UTILITY COMPANY AT LEAST 72 HOURS BEFORE ANY EXCAVATION TO REQUEST EXACT FIELD LOCATION OF UTILITIES. IT SHALL BE THE RESPONSIBILITY OF THE CONTRACTOR TO RELOCATE ALL EXISTING UTILITIES WHICH CONFLICT WITH THE PROPOSED IMPROVEMENTS SHOWN ON THE PLANS.

- RESTORATION NOTES**
1. THE ADJACENT AREAS DISTURBED OR DAMAGED DURING CONSTRUCTION MUST BE RESTORED IN KIND TO THE SATISFACTION OF THE OWNER.
 2. WHEN ADJACENT ASPHALT, CONCRETE OR PAVING STONE AREAS ARE DISTURBED AS PART OF THE CONSTRUCTION, THE CONTRACTOR SHALL BE REQUIRED TO REPLACE THE DAMAGED OR EXCAVATED AREA. THE PERIMETER OF THE DISTURBED AREA SHALL BE SAW CUT FULL DEPTH, SO THAT ALL LINES ARE STRAIGHT AND TRUE. PAVING STONES SHALL BE REPLACED IN WHOLE UNITS ONLY, AND ALL REPLACEMENT PAVING STONES ARE TO MATCH THE EXISTING ONES IN SIZE, SHAPE AND COLOR. ASPHALT SHALL BE COMPACTED TO A SMOOTH FINISH AND SHALL BE FLUSH WITH THE EXISTING ADJACENT AREA THAT IS TO REMAIN.

ACCESSIBLE PARKING SPECIFICATION

THE SLOPE OF THE PAVEMENT WITHIN THE ACCESSIBLE PARKING SPACE AND ACCESSIBLE AISLE SHALL BE 2% MAXIMUM IN ALL DIRECTIONS.

- LEGEND**
- EXISTING CONTOUR
 - PROPOSED CONTOUR
 - APPROXIMATE LIMIT OF SAWCUT/NEW PAVEMENT, MATCH EXISTING, TYP.
 - INLET PROTECTION
 - PROPOSED ELEVATION

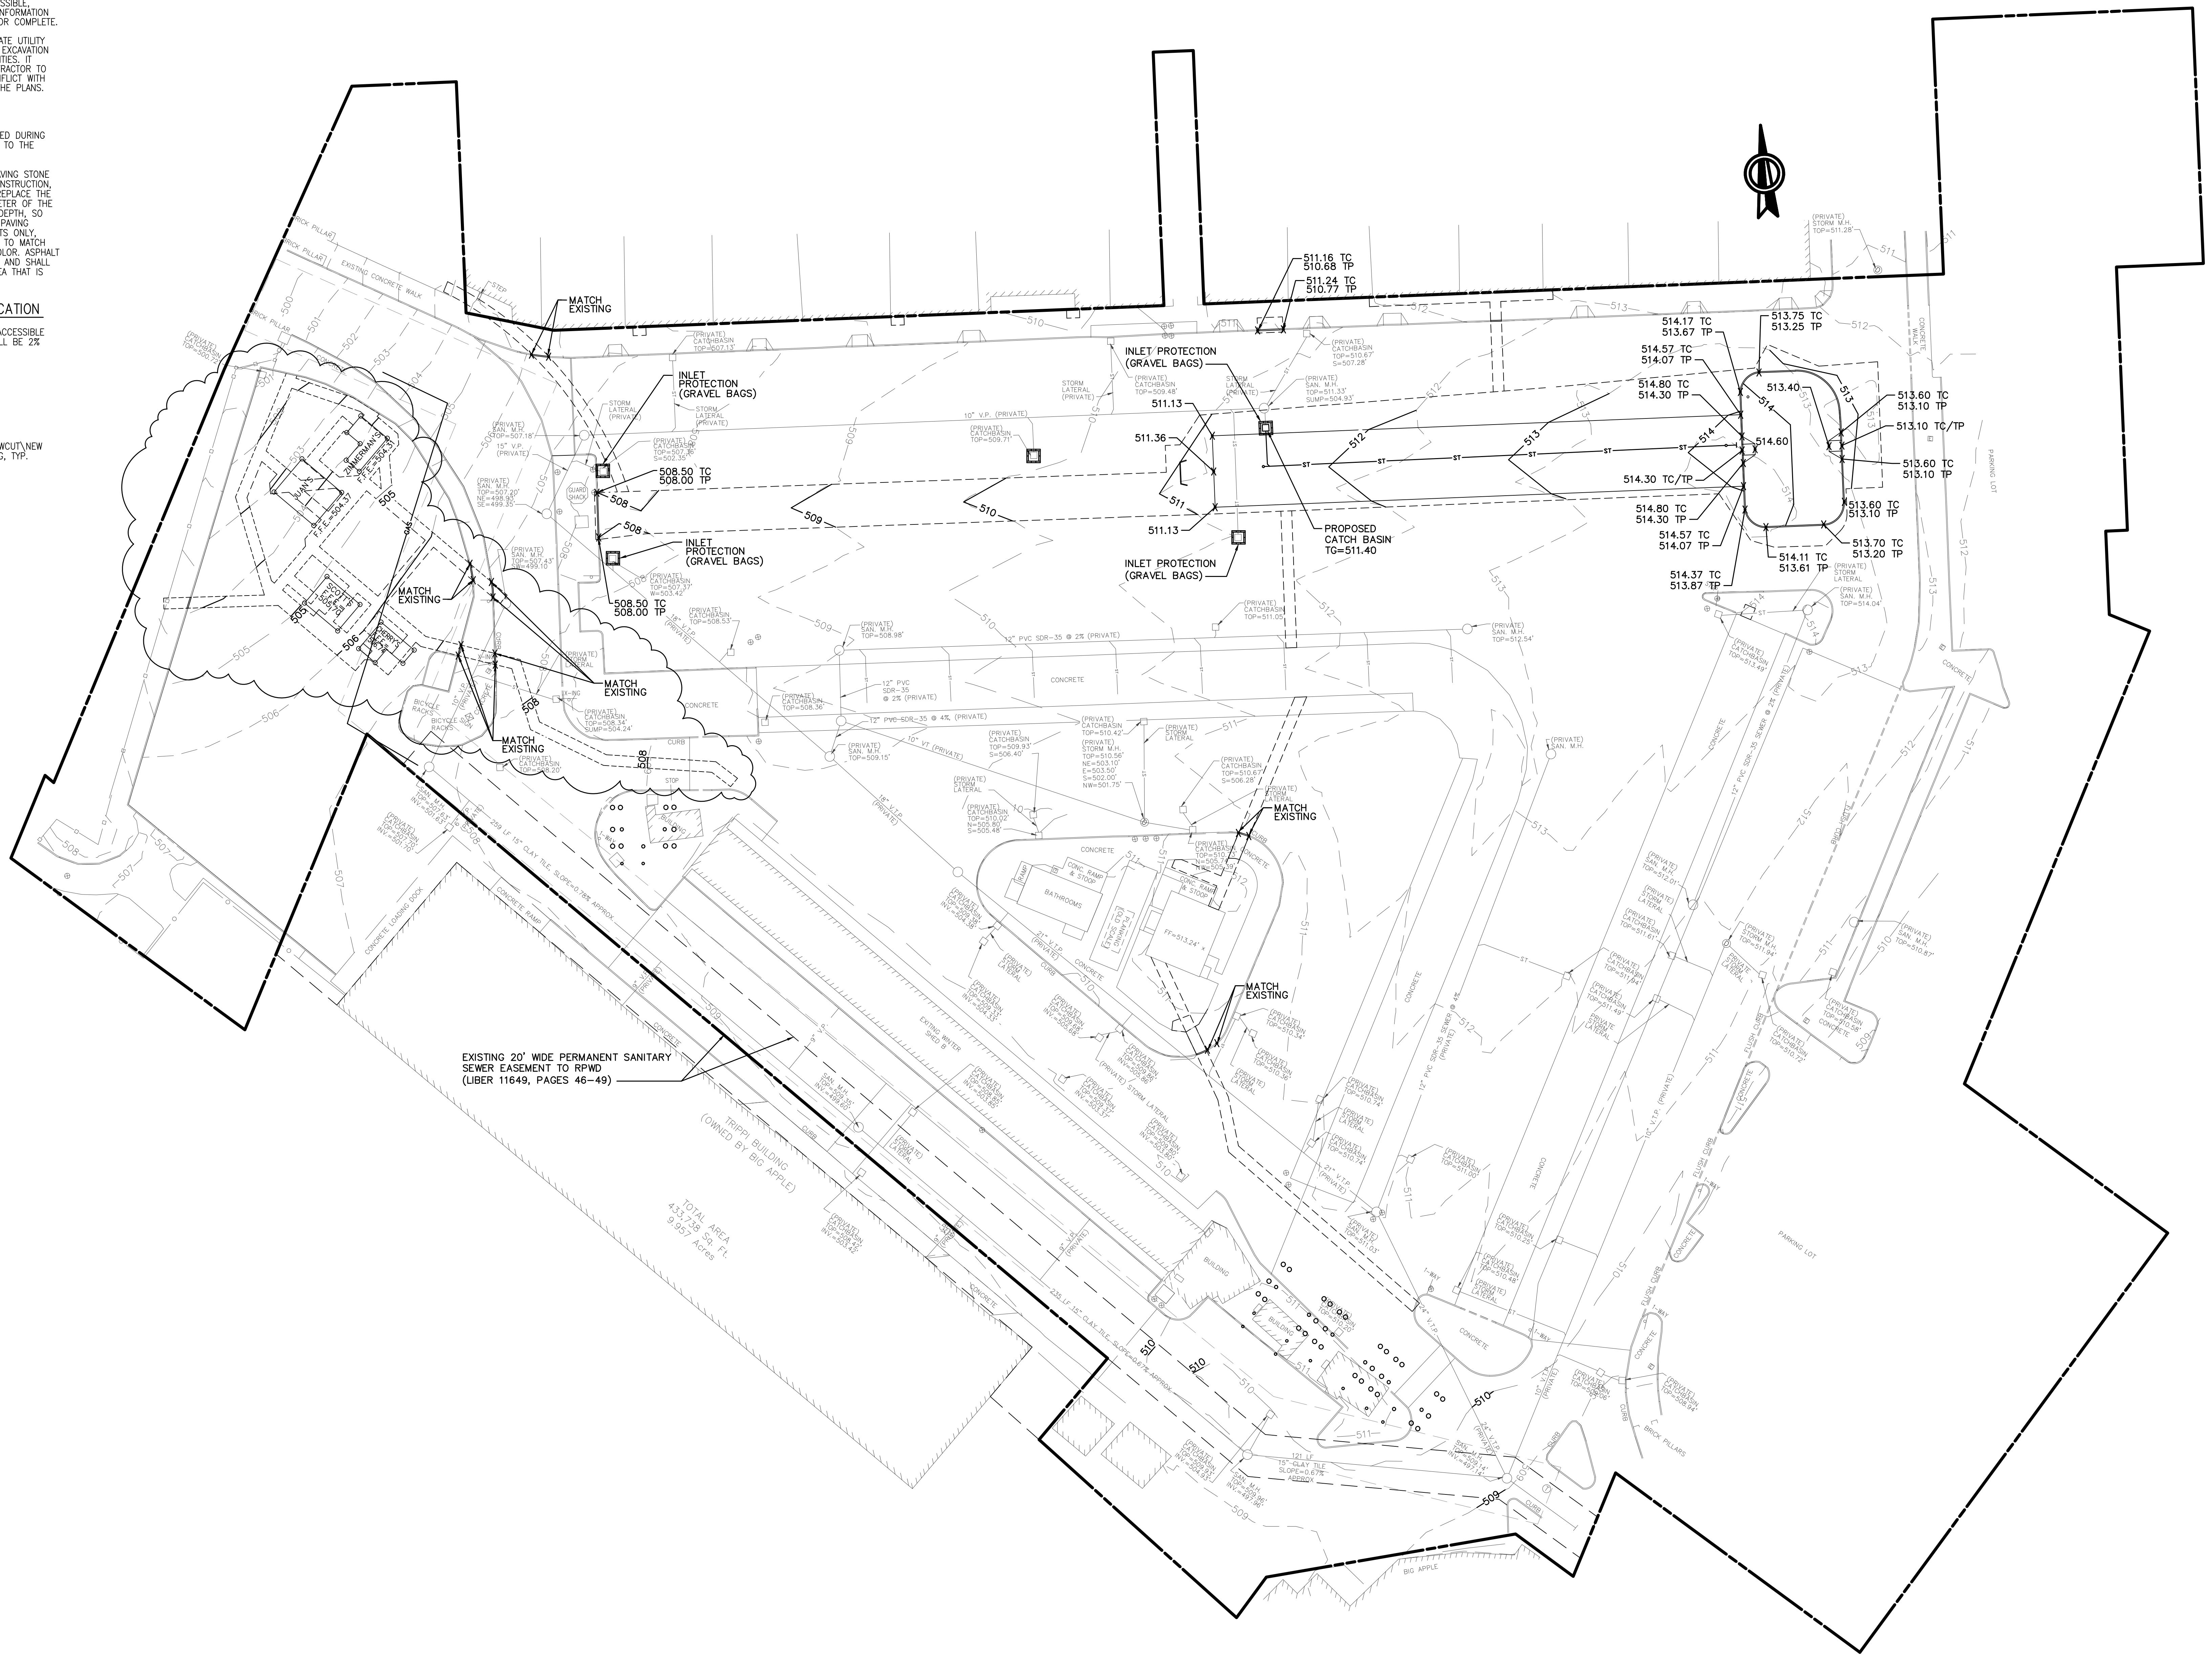

Dig Safely.
New York
800-962-7962
www.digsafelynewyork.org

- ☐ Call Before You Dig
- ☐ Wait The Required Time
- ☐ Confirm Utility Response
- ☐ Respect the Marks
- ☐ Dig With Care

AS-BUILT DRAWINGS

3	08/29/16	REVISED LOCATIONS OF TEMPORARY KIOSKS.
2	08/29/16	REVISED GRADING FOR CONCRETE PAD
1	04/18/16	ADDED SEWER EASEMENT LIBER & PAGE
NO.	DATE:	DESCRIPTION

TYLIN INTERNATIONAL

255 EAST AVENUE
ROCHESTER, NY 14604
(585) 512-2000

GRADING PLAN
SHED D AND TEMPORARY KIOSK LOCATIONS
ROCHESTER PUBLIC MARKET
280 Union Street N, Rochester, NY 14609
ROCHESTER PUBLIC MARKET
30 Church Street, Rochester, NY 14614

PROJECT NO.:	435346.01	PROJ. MGR.	THC
DATE:	11/30/15	DRWN. BY:	JV
SCALE:	1"=30'	CHKD. BY:	RLB
DRAWING NO.	DC104		
SHEET NO.	8 of 73		

UTILITY NOTES.

1. THE CONTRACTOR IS SPECIFICALLY CAUTIONED THAT THE LOCATIONS AND/OR ELEVATIONS OF EXISTING UTILITIES AS SHOWN ON THESE PLANS ARE BASED ON RECORDS OF THE VARIOUS UTILITY COMPANIES AND, WHERE POSSIBLE, MEASUREMENTS TAKEN IN THE FIELD. THE INFORMATION IS NOT TO BE RELIED ON AS BEING EXACT OR COMPLETE. THE CONTRACTOR MUST CALL THE APPROPRIATE UTILITY COMPANY AT LEAST 72 HOURS BEFORE ANY EXCAVATION TO REQUEST EXACT FIELD LOCATION OF UTILITIES. IT SHALL BE THE RESPONSIBILITY OF THE CONTRACTOR TO RELOCATE ALL EXISTING UTILITIES WHICH CONFLICT WITH THE PROPOSED IMPROVEMENTS SHOWN ON THE PLANS.
2. PRIOR TO EXCAVATING NEAR GAS OR ELECTRIC LINES, THE CONTRACTOR SHALL NOTIFY THE APPROPRIATE UTILITY COMPANY.
3. CONTRACTOR TO FIELD VERIFY EXACT LOCATION OF GAS MAIN PRIOR TO CONSTRUCTION.
4. ELECTRIC SERVICE LINES TO BE CONSTRUCTED TO THE APPROPRIATE UTILITY COMPANY SPECIFICATIONS.

LEGEND

- OE,T&C— EXISTING OVERHEAD, TELEPHONE AND CABLE
- T&C— EXISTING TELEPHONE AND CABLE
- OHE— PROPOSED OVERHEAD
- UGE— PROPOSED UNDERGROUND ELECTRIC, TELEPHONE AND CABLE TV SERVICE IN PVC CONDUIT
- G— PROPOSED GAS SERVICE
- W— PROPOSED 2" TYPE "K" COPPER WATER SERVICE
- PROPOSED CATCH BASIN
- PROPOSED WATER VALVE
- ⊕ FIRE HYDRANT
- ⊕ WATER VALVE
- ⊕ WATER MANHOLE
- ⊕ MANHOLE—TELEPHONE
- ⊕ HANDHOLE—TELEPHONE
- ⊕ UTILITY RISER—TELEPHONE
- ⊕ BOLLARD
- ⊕ CLEAN OUT
- ⊕ MANHOLE—STORM SEWER
- ⊕ GAS VALVE
- ⊕ CATCH BASIN
- ⊕ ELECTRIC HANDHOLE
- ⊕ UTILITY POLE
- ⊕ MANHOLE—SANITARY SEWER
- ⊕ 2"x2" HANDHOLE
- ⊕ MANHOLE OR HANDHOLE—TRAFFIC
- ⊕ UTILITY LIGHT POLE
- ⊕ LIGHT POLE
- ⊕ MANHOLE—ELECTRIC

STORM/SANITARY SEWER NOTES

1. MATERIALS
- a. SELECT BACKFILL SHALL CONFORM TO THE REQUIREMENTS OF NYSDOT SPECIFICATIONS, SECTION 203, ITEM 203.07.
- b. BEDDING MATERIAL SHALL CONFORM TO THE REQUIREMENTS OF NYSDOT SPECIFICATIONS, SECTION 203, ITEM 203.07, EXCEPT THAT MAXIMUM PARTICLE SIZE SHALL BE 2".
- c. SUITABLE MATERIAL FROM THE EXCAVATIONS SHALL BE ANY MINERAL (INORGANIC) SOIL FREE OF MUCK, PEAT, INORGANIC SILT, TOPSOIL AND SOD AND SHALL HAVE A MAXIMUM PARTICLE SIZE OF 4".
- d. BACKFILL ABOVE THE BEDDING MATERIAL UNDER PUBLIC ROADWAYS SHALL BE WITH SELECT BACKFILL.
- e. BACKFILL ABOVE THE BEDDING MATERIAL UNDER LAWN AREAS MAY BE WITH SUITABLE MATERIAL FROM THE EXCAVATIONS.
- f. BACKFILL ABOVE THE BEDDING MATERIAL UNDER PRIVATE PAVED AREAS MAY BE WITH SUITABLE MATERIAL FROM THE EXCAVATIONS, AS LONG AS COMPACTION REQUIREMENTS ARE MET. IF COMPACTION REQUIREMENTS ARE NOT MET WITH SUITABLE MATERIAL FROM THE EXCAVATIONS, SELECT BACKFILL SHALL BE PROVIDED.
- g. WHEN UNSTABLE TRENCH BOTTOM CONDITIONS ARE ENCOUNTERED, UNDERCUT AND BACKFILL WITH PRIMARY SIZE STONE, NYSDOT SPECIFICATIONS, SECTION 703-02, PRIMARY SIZE 1.2, 3 OR 4. DEPTH OF UNDERCUT SHALL BE AS SPECIFIED BY OWNER'S REPRESENTATIVE.
2. COMPACTION REQUIRED FOR ALL BEDDING, SELECT FILL AND BACKFILL WORK. SEE NYSDOT SPECIFICATIONS, SECTION 203 FOR REQUIREMENTS.
3. FRAME AND COVER TO BE CAST IRON, ASTM A-48, CLASS 30, HS-20 LOADING. LOCAL MUNICIPAL STANDARD FOR DEDICATED SEWERS FOR PRIVATE SEWERS, USE SYRACUSE CASTING NO. 1032 OR EQUIVALENT.
4. ALL DRAINAGE STRUCTURES TO HAVE OPEN GRATING TOP UNLESS OTHERWISE NOTED ON UTILITY PLAN.
5. FLOOR DRAINS, IF CONSTRUCTED, SHALL BE CONNECTED TO THE SANITARY SEWER. FLOOR DRAINS DO NOT INCLUDE FOUNDATION OR FOOTER DRAINS INSTALLED TO INTERCEPT UNCONTAMINATED GROUNDWATER. ALL DISCHARGES TO THE SANITARY SEWER MUST COMPLY WITH THE EFFLUENT LIMITS OF THE LOCAL SEWER USE LAW. INFILTRATION AND EXFILTRATION TESTING SHALL BE PERFORMED WITH RATES LIMITED TO 100 GALLONS PER MILE PER INCH DIAMETER OF PIPE PER 24 HOURS FOR SANITARY SEWERS.
6. DEFLECTION TESTS SHALL BE PERFORMED ON ALL FLEXIBLE PIPE. THE TEST SHALL BE CONDUCTED AFTER THE FINAL BACKFILL HAS BEEN IN PLACE AT LEAST 30 DAYS. NO PIPE SHALL EXCEED A DEFLECTION OF 5%. IF THE DEFLECTION TEST IS TO BE RUN USING A RIGID BALL OR MANHOLE, IT SHALL HAVE A DIAMETER EQUAL TO 95% OF THE INSIDE DIAMETER OF THE PIPE. THE TEST SHALL BE PERFORMED WITHOUT MECHANICAL PULLING DEVICES.
7. CONTRACTOR SHALL BE RESPONSIBLE FOR VERIFYING PROPOSED RIM ELEVATIONS IN RELATION TO PROPOSED GRADE PRIOR TO INSTALLATION.
8. PIPE CONNECTIONS TO STORM MANHOLES SHALL BE WITH NON-SHRINK GROUT. PIPE CONNECTIONS TO SANITARY SEWER MANHOLES SHALL CONFORM TO ANSI/ASTM C12 REQUIREMENTS.
9. STORM PIPES SHALL BE SDR-21 PER PURE WATERS CONSTRUCTION DETAIL. SANITARY PIPES SHALL BE SDR-21 PVC CONFORM WITH ASTM D2241 @ 1.00% MIN. SLOPE.

NOTES FOR WATERMAIN INSTALLATION

1. MATERIALS
- a. SELECT BACKFILL SHALL CONFORM TO THE REQUIREMENTS OF NYSDOT SPECIFICATIONS, SECTION 203, ITEM 203.07.
- b. BEDDING MATERIAL SHALL CONFORM TO THE REQUIREMENTS OF NYSDOT SPECIFICATIONS, SECTION 203, ITEM 203.07, EXCEPT THAT MAXIMUM PARTICLE SIZE SHALL BE 2".
- c. SUITABLE MATERIAL FROM THE EXCAVATIONS SHALL BE ANY MINERAL (INORGANIC) SOIL FREE OF MUCK, PEAT, ORGANIC SILT, TOPSOIL AND SOD, AND SHALL HAVE A MAXIMUM PARTICLE SIZE OF 4".
- d. BACKFILL ABOVE THE BEDDING MATERIAL UNDER PUBLIC ROADWAYS SHALL BE WITH SELECT BACKFILL.
- e. BACKFILL ABOVE THE BEDDING MATERIAL UNDER LAWN AREAS MAY BE WITH SUITABLE MATERIAL FROM THE EXCAVATIONS.
- f. BACKFILL ABOVE THE BEDDING MATERIAL UNDER PRIVATE PAVED AREAS MAY BE WITH SUITABLE MATERIAL FROM THE EXCAVATIONS, AS LONG AS COMPACTION REQUIREMENTS ARE MET. IF COMPACTION REQUIREMENTS ARE NOT MET WITH BACKFILL MATERIAL FROM THE EXCAVATIONS, SELECT BACKFILL SHALL BE PROVIDED.
- g. WHEN UNSUITABLE TRENCH BOTTOM CONDITIONS ARE ENCOUNTERED, UNDERCUT AND BACKFILL WITH PRIMARY SIZE STONE, NYSDOT SPECIFICATIONS, SECTION 703-02, PRIMARY SIZE 1.2, 3 OR 4. DEPTH OF UNDERCUT SHALL BE AS SPECIFIED BY OWNER'S REPRESENTATIVE.
2. COMPACTION REQUIRED FOR ALL BEDDING, SELECT FILL AND BACKFILL WORK. SEE NYSDOT SPECIFICATIONS, SECTION 203, ITEM 203.07 FOR REQUIREMENTS.
3. TEMPORARY BLOW-OFF ASSEMBLIES SHALL BE INSTALLED BY THE CONTRACTOR WHERE SHOWN ON THE UTILITY PLAN AND SHALL REMAIN IN PLACE UNTIL APPROVAL OF ALL FLUSHING, PRESSURE TESTING AND BLOWOFF ASSEMBLY, AND EXTEND THE MAIN INTO THE BUILDING WATER SYSTEM. THE CONTRACTOR SHALL SHUT THE UPSTREAM GATE VALVE(S), RELEASE ANY PRESSURE THROUGH THE BLOWOFF, REMOVE THE TEMPORARY PLUG AND BLOWOFF ASSEMBLY, AND EXTEND THE MAIN INTO THE BUILDING. ALL FITTINGS AND PIPE INSTALLED DOWNSTREAM OF THE TEMPORARY BLOWOFF ASSEMBLY SHALL BE CLEANED AND SWABBED WITH 1% HYPOCHLORITE SOLUTION IN ACCORDANCE WITH AWWA STANDARD C651-86, SECTION 9.2.
4. ALL TAPS OR CONNECTIONS TO MUNICIPAL WATER MAINS SHALL BE COORDINATED BY THE CONTRACTOR WITH THE LOCAL WATER AGENCY. THE CONTRACTOR SHALL NOT OPERATE ANY MUNICIPAL VALVES.
5. FLUSHING AND PRESSURE TESTING OF ALL NEW MAINS IN ACCORDANCE WITH AWWA STANDARD C600 IS REQUIRED. DISINFECTION AND BACTERIA SAMPLING OF ALL NEW WATER MAINS IN ACCORDANCE WITH AWWA STANDARD C651 IS REQUIRED. NEW MAINS SHALL NOT BE PLACED IN SERVICE UNTIL WRITTEN ACCEPTANCE FROM THE HEALTH DEPARTMENT IS RECEIVED BY THE LOCAL WATER AGENCY AND THE OWNER'S REPRESENTATIVE.
6. FITTINGS SHALL BE MECHANICAL JOINT CAST IRON OR DUCTILE IRON, CEMENT LINED (AWWA C111 FOR FULL BODY FITTINGS). VALVES SHALL BE IRON BODY, BRONZE MOUNT, DOUBLE DISK GATE VALVES (AWWA C509, KENNEDY OR MUELLER).
7. WATER SERVICE TO BE 6 INCHES MINIMUM VERTICAL SEPARATION OVER THE SEWER.
8. WATER SERVICE TO BE 18" MINIMUM VERTICAL SEPARATION BELOW SEWER LINES.
9. WHERE THE WATER MAIN IS PROPOSED TO BE ABOVE THE SEWER, HORIZONTAL SEPARATION BETWEEN WATER MAIN AND SEWER LINES WILL BE A MINIMUM OF 3 FEET. ABOVE IS DEFINED AS THOSE SITUATIONS WHERE THE INVERT OF THE WATER MAIN IS 6 INCHES ABOVE THE TOP OF THE SEWER.
10. CLEANOUTS SHALL BE INSTALLED ON ALL 4" AND 6" DIAMETER SEWER LATERALS AT THE RIGHT-OF-WAY (ROW) LINE OR THE SEWER EASEMENT LINE WHERE APPLICABLE. (THE SEWER EASEMENT, RIGHT-OF-WAY OR PROPERTY LINE MUST BE STAKED OUT PRIOR TO INSTALLATION OF LOT LINE CLEANOUTS TO ENSURE PROPER LOCATION OF THE CLEANOUTS. (REFER TO CLEANOUT DETAIL FOR PROPER INSTALLATION)).
11. IF AN EXISTING LATERAL IS TO BE UTILIZED, THE PLUMBER/CONTRACTOR MUST ENSURE THAT THE LATERAL IS IN GOOD CONDITION AND IS FREE OF DEBRIS (DIRT, MUD, STONE, ROOTS, ETC.) VIA A VIDEO TAPED INSPECTION PERFORMED BY THE PLUMBER/CONTRACTOR OR HIS/HER/THEIR AGENT. PRIOR TO CONNECTION, THE VIDEO TAPED INSPECTION OF THE EXISTING LATERAL MUST BE PRESENTED TO THE DISTRICT FOR REVIEW AND APPROVAL TO UTILIZE AN EXISTING LATERAL. IT IS THE RESPONSIBILITY OF THE BUILDER OR THEIR AGENT TO CLEAN AND/OR REPLACE THE PIPE/LATERAL AS NEEDED.
12. ANY NEW PORTION OF A SEWER LATERAL INSTALLED WITHIN THE PUBLIC RIGHT-OF-WAY AND SEWER EASEMENT MUST BE SDR-21 PVC.
13. ANY EXISTING LATERALS NOT UTILIZED MUST BE ABANDONED TO MONROE COUNTY PURE WATERS (MCPW) STANDARDS AT THE PROPERTY LINE OR, WHERE APPLICABLE, THE SEWER EASEMENT LINE.
14. FLOOR DRAINS IF CONSTRUCTED, SHALL BE CONNECTED TO THE SANITARY/COMBINATION SEWER. FLOOR DRAINS DO NOT INCLUDE FOUNDATION/FOOTER DRAINS. ALL DISCHARGES TO THE SANITARY/COMBINATION SEWER MUST COMPLY WITH THE EFFLUENT LIMITS OF THE LOCAL AND/OR MONROE COUNTY SEWER USE LAW.

EXISTING 20' WIDE PERMANENT
SANITARY SEWER EASEMENT TO
RPWD (LIBER 11649, PAGES 46-49)

WATER SERVICE LINE NOTES

1. WATER SERVICE LINES (LATERALS) SHALL BE CONSTRUCTED IN ACCORDANCE WITH THE REGULATIONS AND SPECIFICATIONS OF THE CITY OF ROCHESTER WATER BUREAU DEPARTMENT. AND ANSI/AWWA C151/A21.51.
2. WATER SERVICE LINES SHALL HAVE A MINIMUM OF FIVE FEET OF COVER FROM FINISHED GRADE IN LAWN AREAS AND SIX FEET OF COVER FROM FINISHED GRADE IN PAVED AREAS.
3. WATER SERVICE LINES SHALL BE SEPARATED AT LEAST TEN FEET, MEASURED FROM THE OUTSIDE OF THE PIPES TO SEWER MAINS.
4. WATER SERVICE LINES SHALL BE IDENTIFIED AS:
- | DESCRIPTION | SIZE | MATERIAL (a) | TYPE (b) |
|--|------|-----------------|----------|
| PUBLIC PORTION = FROM THE WATER MAIN TO CURB BOX | 12" | CLASS-52 D.I.P. | DS |
| PRIVATE PORTION = FROM CURB BOX TO POINT OF CONNECTION | 2" | ASTM B-88 | DS |
- (a) ACCEPTABLE MATERIAL IS TYPE "K" COPPER, ASTM B-88 SOFT TEMPER COPPER OR CLASS-52 D.I.P.
- (b) SERVICE TYPES INCLUDE: DOMESTIC = DS, FIRE = FS, OR COMBINED = CMB
5. WATER METER(S) PROVIDED BY RPWD TO BE LOCATED ON THE INTERIOR OF EXTERIOR WALL(S) IMMEDIATELY UPON SERVICE ENTRANCE INTO THE BUILDING(S).
6. WATER SERVICE LINES SIZED 4-INCHES OR GREATER SHALL BE:
- PRESSURE TESTED IN ACCORDANCE WITH CITY OF ROCHESTER WATER BUREAU DEPARTMENT.
 - DISINFECTED IN ACCORDANCE WITH AWWA C 651 DISINFECTING WATER MAINS AND THE REQUIREMENTS OF THE NEW YORK STATE DEPARTMENT OF HEALTH. A WATER SAMPLE SHALL BE COLLECTED BY THE WATER DEPARTMENT AND ANALYZED BY A NEW YORK STATE DEPARTMENT OF HEALTH APPROVED TESTING LABORATORY FOR BACTERIOLOGICAL CONTENT. THE CONTRACTOR SHALL PAY ALL LABORATORY CHARGES. THE WORK WILL NOT BE ACCEPTED UNTIL A REPORT IS SUBMITTED TO THE ENGINEER SHOWING THAT A WATER SAMPLE IS SATISFACTORY AND THE SYSTEM IS READY TO USE.

UTILITY COMPANIES

WATER

CITY OF ROCHESTER WATER BUREAU
10 FELIX STREET
ROCHESTER, NY 14608
ATTN: Steve Poliszuk
PHONE (585) 428-6379

HEALTH DEPARTMENT

MONROE COUNTY DEPARTMENT OF HEALTH
111 WESTFALL ROAD
ROCHESTER, NY 14692
ATTN: Scott Hulse
PHONE (585) 753-2991
FAX (585) 753-5115

SANITARY/STORM SEWER

MODES-DIVISION OF PURE WATERS
OFFICE OF DEVELOPMENT REVIEW
444 EAST HENRIETTA ROAD, BLDG. 15
ROCHESTER, NY 14620
ATTN: Richard Blomchi, Senior Pure Waters
PHONE (585) 753-7614
FAX (585) 324-4255

GAS

ROCHESTER GAS & ELECTRIC
89 EAST AVENUE
ROCHESTER, NY 14649
ATTN: Richard Sidoti, ENGINEER
PHONE (585) 340-0546

ELECTRIC

ROCHESTER GAS & ELECTRIC
89 EAST AVENUE
ROCHESTER, NY 14649
ATTN: Joanne Rowley, Engineer
PHONE (585) 777-1136
FAX (585) 427-0246

TELEPHONE

FRONTIER COMMUNICATIONS
3441 WEST HENRIETTA ROAD
ROCHESTER, NY 14623
ATTN: Dove Watkins, Outside Plant Engineer
PHONE (585) 777-1136
FAX (585) 427-0246

CABLE

TIME WARNER CABLE
71 MOUNT HOPE AVENUE
ROCHESTER, NY 14620
ATTN: Phil Brooks, Engineer Representative
PHONE (585) 756-1308
FAX (585) 756-1318

11. ANY PORTION OF A SEWER/LATERAL WITH LESS THAN FOUR-FEET (4') OF COVER WILL REQUIRE CONCRETE EASEMENT. SEWERS/LATERALS WITH LESS THAN THREE-FEET (3') OF COVER ARE NOT ALLOWED.
12. THE REQUIREMENTS OF THE HIGHWAY/PROPERTY OWNER SHALL BE ADHERED TO FOR ITEMS ABOVE THE PIPE BEDDING, INCLUDING, BUT NOT LIMITED TO, MAINTENANCE AND PROTECTION OF TRAFFIC, BACKFILL MATERIAL AND SURFACE RESTORATION.
13. ALL ROCHESTER PURE WATERS DISTRICT EASEMENTS ARE TO BE STAKED OUT IN THE FIELD BY AN ENGINEER/SURVEYOR PRIOR TO THE START OF ANY SITE CONSTRUCTION/EXCAVATION AND MAINTAINED DURING COURSE OF PROJECT TO ENSURE THAT NO DISCHARGES TO THE DISTRICTS' EASEMENT. IT IS THE OWNER'S OR OWNER'S REPRESENTATIVE'S RESPONSIBILITY TO STAKE OUT ALL EASEMENTS.


Dig Safely.
New York
800-962-7962
www.digsafelynewyork.org

- Call Before You Dig
□ Wait The Required Time
□ Confirm Utility Response
□ Respect the Marks
□ Dig With Care

MCPW-ROCHESTER PURE WATERS DISTRICT SEWER

NOTES FOR SEWER LATERAL CONNECTIONS:

1. THIS PLAN REQUIRES APPROVAL AND ISSUANCE OF A PLUMBING PERMIT FROM THE CITY OF ROCHESTER PLUMBING DEPARTMENT.
2. PRIOR TO CONSTRUCTION, A SEWER CONNECTION PERMIT MUST BE OBTAINED FROM THE MONROE COUNTY PURE WATERS (MCPW) PERMIT OFFICE AT 444 EAST HENRIETTA ROAD, BUILDING 15, ROCHESTER, NEW YORK 14620-4643, PHONE # 753-7600 (OPT. 5).
3. SEWER CONNECTION PERMIT(S) CAN ONLY BE ISSUED TO A PLUMBER LICENSED IN THE CITY OF ROCHESTER AND WHO IS FULLY INSURED AND BONDED IN THE ROCHESTER PURE WATERS DISTRICT (RPWD). PAYMENT (CHECK OR MONEY ORDER TO RPWD) OF ALL APPLICABLE PERMIT FEES MUST BE PAID PRIOR TO PERMIT ISSUANCE.
4. THE RPWD SHALL BE NOTIFIED FORTY-EIGHT HOURS IN ADVANCE OF A CONNECTION OR TAP. (753-7600 (OPT. 5)). THE CONTRACTOR SHALL MAKE ALL REQUIRED TAPS TO THE RPWD SEWERS. ALL TAPS AND CONNECTIONS TO DISTRICT UTILITIES MUST BE WITNESSED BY A DISTRICT INSPECTOR.
5. SANITARY/STORM/COMBINATION SEWER LATERAL(S) AND APPURTENANCES SHALL BE CONSTRUCTED IN CONFORMANCE WITH THE REQUIREMENTS OF THE ROCHESTER PURE WATERS DISTRICT.

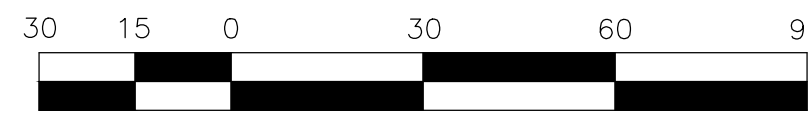

AS-BUILT DRAWINGS

NO.	DATE	DESCRIPTION	REVISIONS
1	08/29/16	REVISED LOCATIONS OF TEMPORARY KIOSKS.	
2	04/18/16	ADDED SEWER EASEMENT LIBER & PAGE.	

11/30/15
DATE

TYLININTERNATIONAL
265 EAST AVENUE
ROCHESTER, NY 14604
(585) 512-2000

UTILITY PLAN
D AND TEMPORARY KIOSK LOCATIONS
SHED D AND TEMPORARY KIOSK LOCATIONS
PROJECT NAME: ROCHESTER PUBLIC MARKET
CLIENT: ROCHESTER PUBLIC MARKET
30 Church Street, Rochester, NY 14614

PROJECT NO.: 435346.01	PROJ. MGR. THC
DATE: 11/30/15	DRWN. BY: JV
SCALE: 1"=30'	CHWD. BY: RLB
DRAWING NO. DC105	
SHEET NO. 9	OF 73

PHASE 1

PHASE 1A

1. INSTALL NEW LIGHT POLES AND OVERHEAD LINE TO MAINTAIN POWER ON EXISTING BUILDINGS.
2. INSTALL NEW UNDERGROUND CONNECTION BETWEEN EXISTING WINTER SHED AND ADMINISTRATION BLDG. FOR NEW POWER TO SHED "D" AND PROPOSED TRANSFORMER ON PHASE 2.
3. REMOVE EXISTING CONCRETE AND LIGHT POLES AT PARKING AREA, INCLUDING PLANTING AREAS AND CONCRETE CURBS AS SHOWN IN THE DEMOLITION PLAN.
4. MAINTAIN 15 FT MIN. TRAFFIC LANE FOR CUSTOMERS AND VENDORS DURING DEMOLITION AND CONSTRUCTION PHASE. THIS WILL BE BETWEEN EXISTING RESTAURANTS AND TEMPORARY FENCE.
5. MAINTAIN EXISTING PARKING SPACES IN PHASE 1B FOR CUSTOMERS AND VENDORS UNTIL PHASE 1A COMPLETED.
6. CONSTRUCT UTILITIES TO NEW PARKING AREA AND ADJACENT BUILDINGS. THIS SHALL BE DONE DURING NO MARKET OPERATION HOURS.
7. CONSTRUCT NEW PARKING AREA AND INSTALL NEW LIGHT POLES.
8. STRIPE NEW PARKING AREA INCLUDING NEW ADA SPACES.
9. OPEN NEW PARKING AREA TO THE PUBLIC.
10. TRAFFIC SIGNS TO BE REMOVED DURING MARKET OPERATION, AND ALL TRENCHES SHALL BE COVERED WITH STEEL PLATES IF CONSTRUCTION NOT FINISHED BY THE END OF THE DAY.

PHASE 1B

1. STRIPE NEW PARKING SPACES AT FRONT EXISTING BUILDINGS.
2. MAINTAIN 15 FT MIN. TRAFFIC LANE FOR CUSTOMERS AND VENDORS DURING DEMOLITION AND CONSTRUCTION PHASE. THIS WILL BE BETWEEN PROPOSED PARKING STRIPES AND TEMPORARY FENCE.
3. REMOVE EXISTING LIGHT POLES AND OVERHEAD LINES, INCLUDING EXISTING CONCRETE CURBS AND PLANTING AREAS AS SHOWN IN THE DEMOLITION PLAN.
4. CONSTRUCT UTILITIES TO SHED "D" AND SHED "A". ALL TRENCHES SHALL BE COVERED WITH STEEL PLATES IF CONSTRUCTION NOT FINISHED BY THE END OF THE DAY.
5. CONSTRUCT PROPOSED SHED "D".
6. RE-PAVE AREA PER GRADING PLAN.
7. OPEN NEW FACILITY TO THE PUBLIC.
8. CONTRACTOR REFER TO ARCHITECTURAL PLANS FOR PROPOSED SHED "D" BUILDING TEMPORARY MODIFICATION FOR WINTER SEASON.

PHASE 1C

1. REMOVE EXISTING OVERHEAD LINES.
2. CONSTRUCT UTILITIES TO ADMINISTRATION BUILDING AND PROPOSED SHED "D".
3. INSTALL NEW LIGHT POLE.
4. CONSTRUCT UTILITIES FOR TEMPORARY KIOSKS. DURING EXCAVATION CONTRACTOR SHALL ALLOW TRAFFIC TO BIG APPLE DELIVERY TRUCKS ONLY AT ALL TIME. TRENCHES TO BE COVERED WITH STEEL PLATES IF CONSTRUCTION NOT FINISHED BY THE END OF THE DAY. CONTRACTOR SHALL DO THIS WORK DURING NO MARKET OPERATION HOURS.
5. CONTRACTOR IS RESPONSIBLE TO RESTORE ALL DISTURBED AREAS TO ITS ORIGINAL CONDITIONS.



LEGEND

- 1A CONSTRUCTION PHASE
- AREA OF CONSTRUCTION DURING PHASE
- X TEMPORARY CONSTRUCTION FENCE

SUMMARY OF TEMPORARY TRAFFIC CONTROL DEVICES				
SYM	ITEM	KEY	DESC.	QTY.
1	ROAD CLOSED	R11-2 (48"x30")		4
2	TYPE III BARRICADE		TYPE III BARRICADE	4

Dig Safely.
New York
800-962-7962
www.digsafelynewyork.org

- ☐ Call Before You Dig
- ☐ Wait The Required Time
- ☐ Confirm Utility Response
- ☐ Respect the Marks
- ☐ Dig With Care

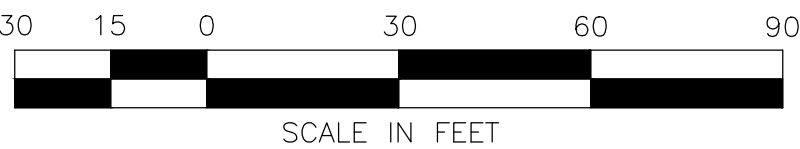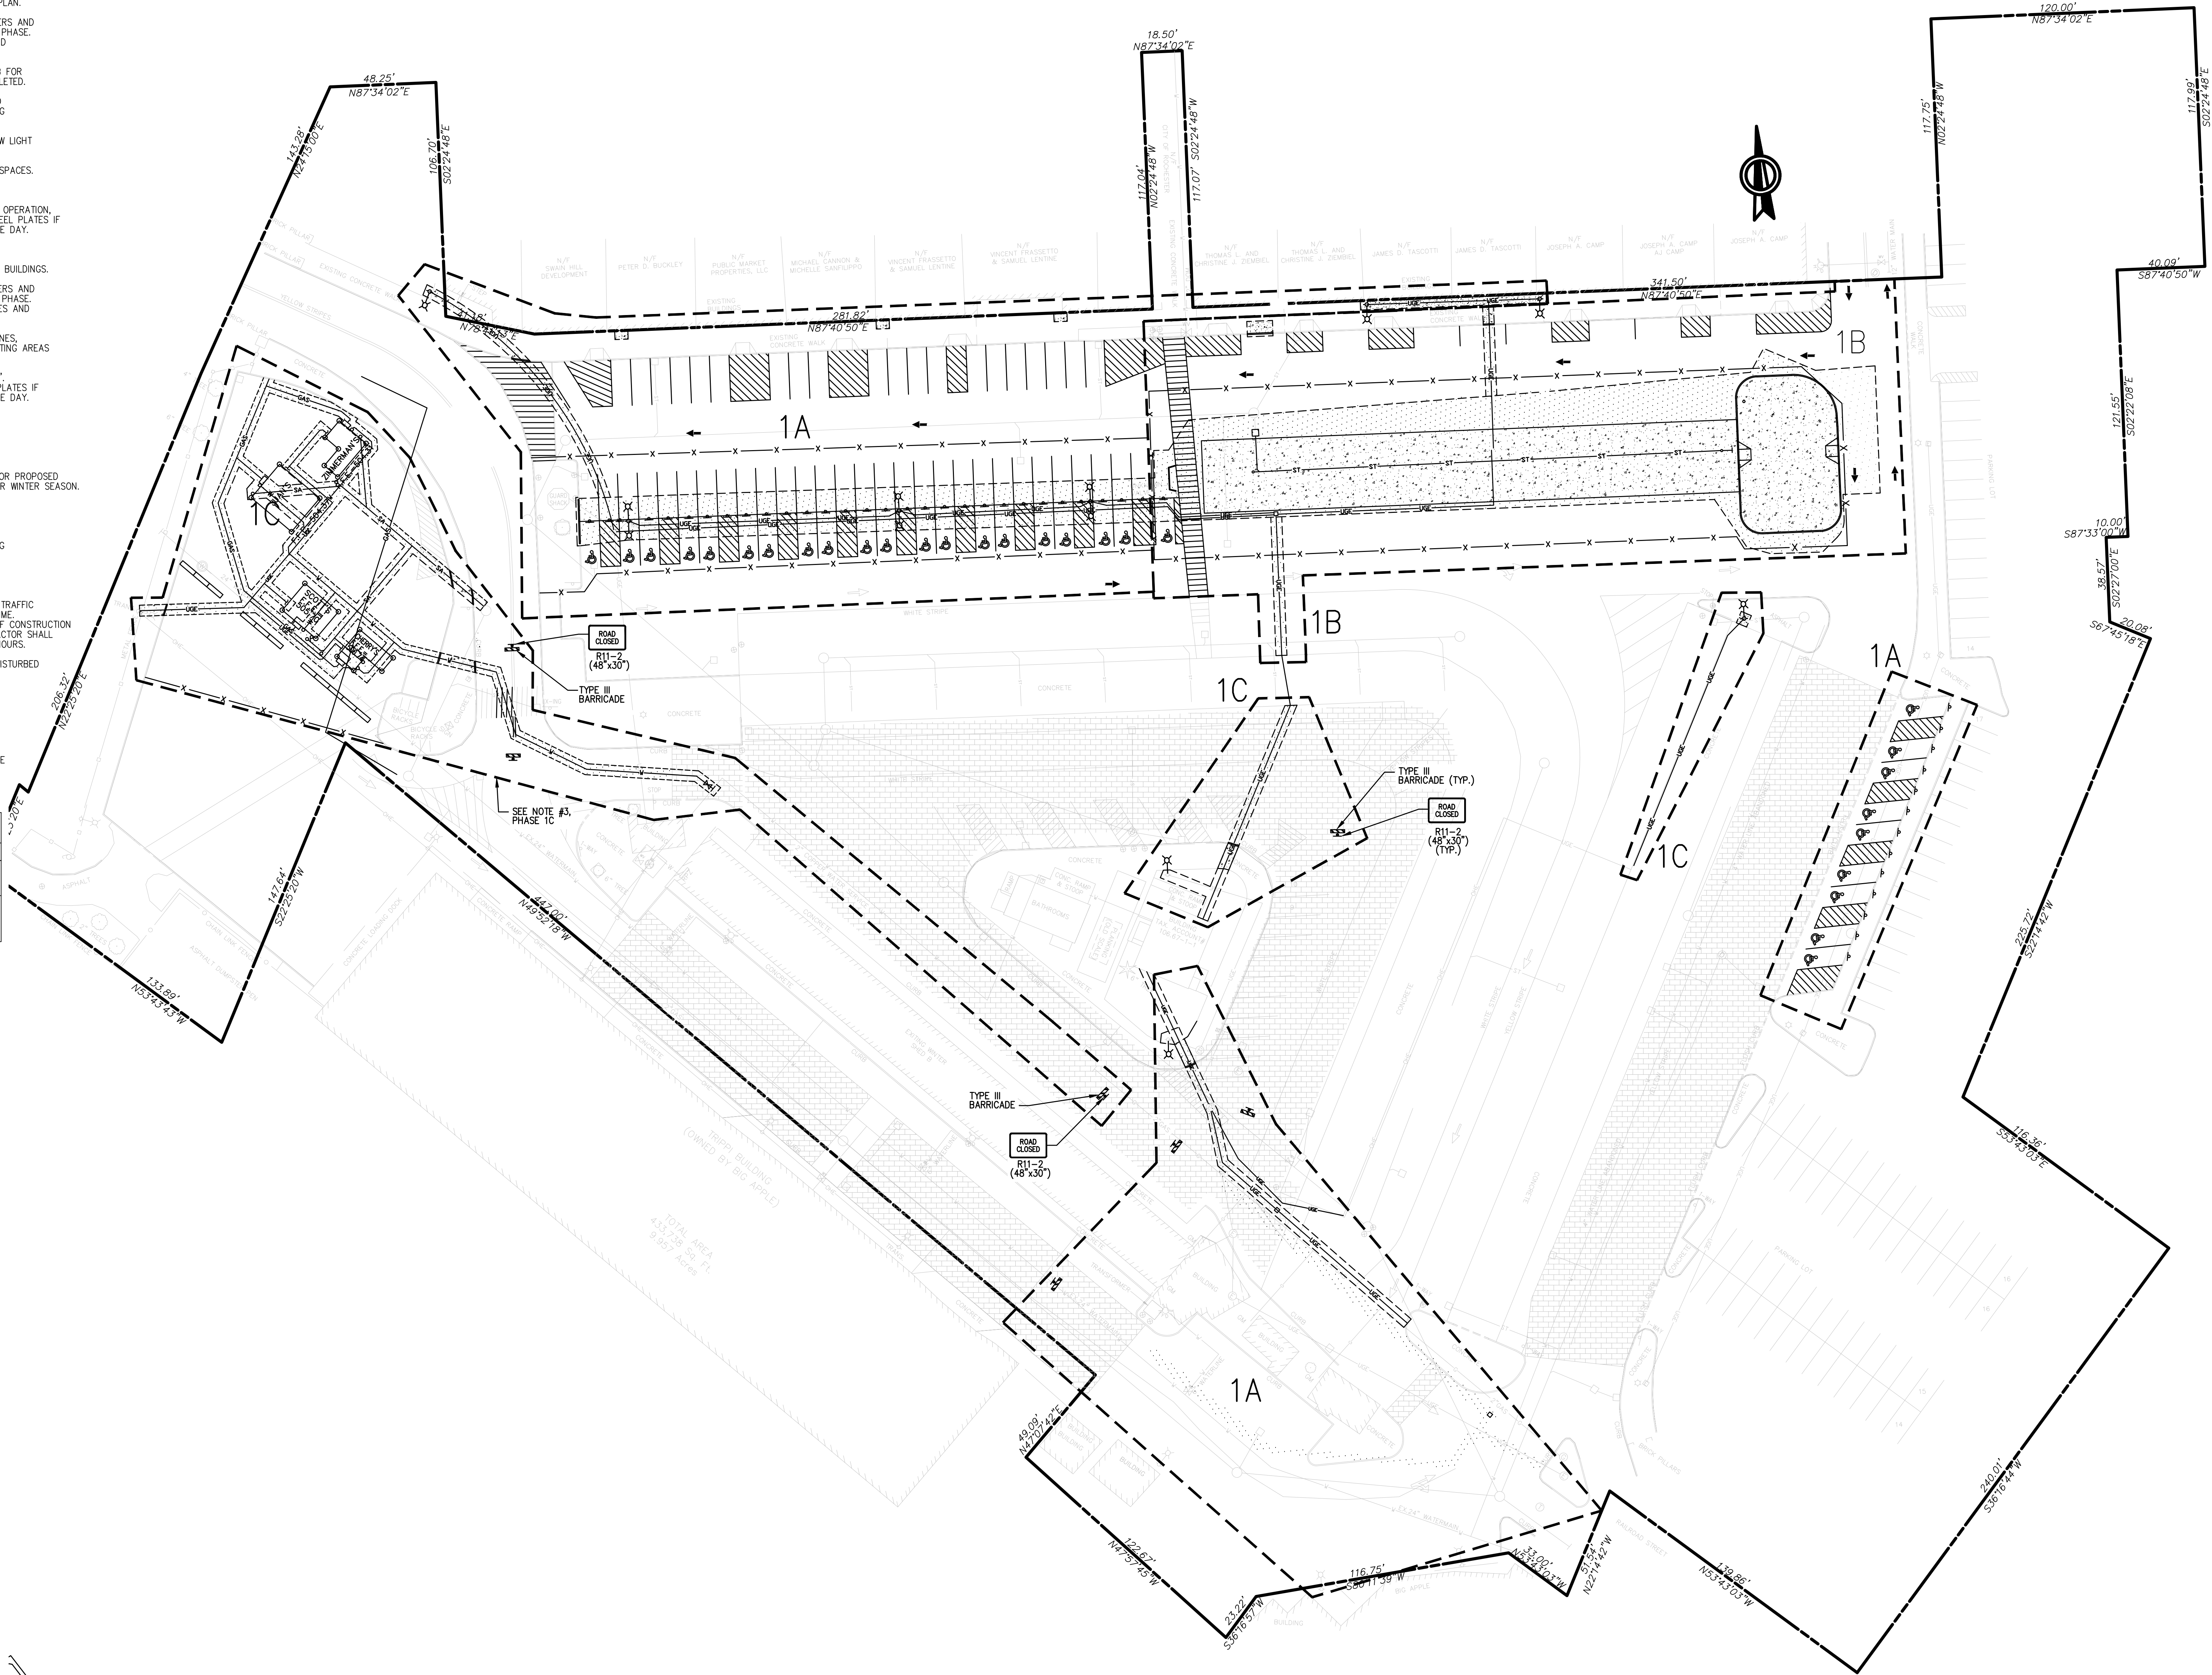

AS-BUILT DRAWINGS

















UNAUTHORIZED ALTERATION OR ADDITION TO THIS DRAWING IS A VIOLATION OF NEW YORK STATE EDUCATION LAW ARTICLE 143, SECTION 7209			
NO.	DATE	DESCRIPTION	REVISIONS
1	04/18/16	ADDED SEWER EASEMENT LIBER & PAGE.	

11/30/15
DATE

TYLIN INTERNATIONAL
255 EAST AVENUE
ROCHESTER, NY 14604
(585) 512-2000

DRAWING FILE:	PHASING PLAN - 1
PROJECT NAME:	SHED D AND TEMPORARY KIOSK LOCATIONS
CLIENT:	ROCHESTER PUBLIC MARKET

PROJECT NO.:	PROJ. MGR.
435346.01	THC
DATE:	DRWN. BY:
11/30/15	JV
SCALE:	CHKD. BY:
1"=30'	RLB
DRAWING NO:	
SHEET NO:	
DC106	
10 of 73	

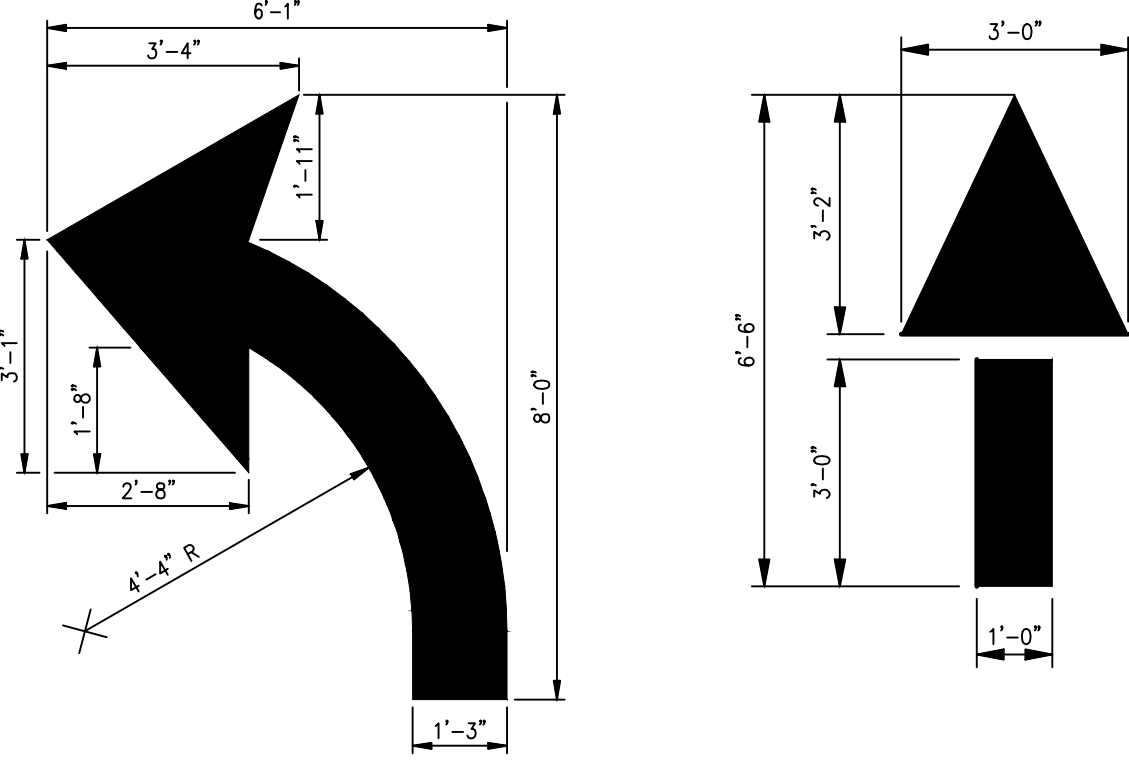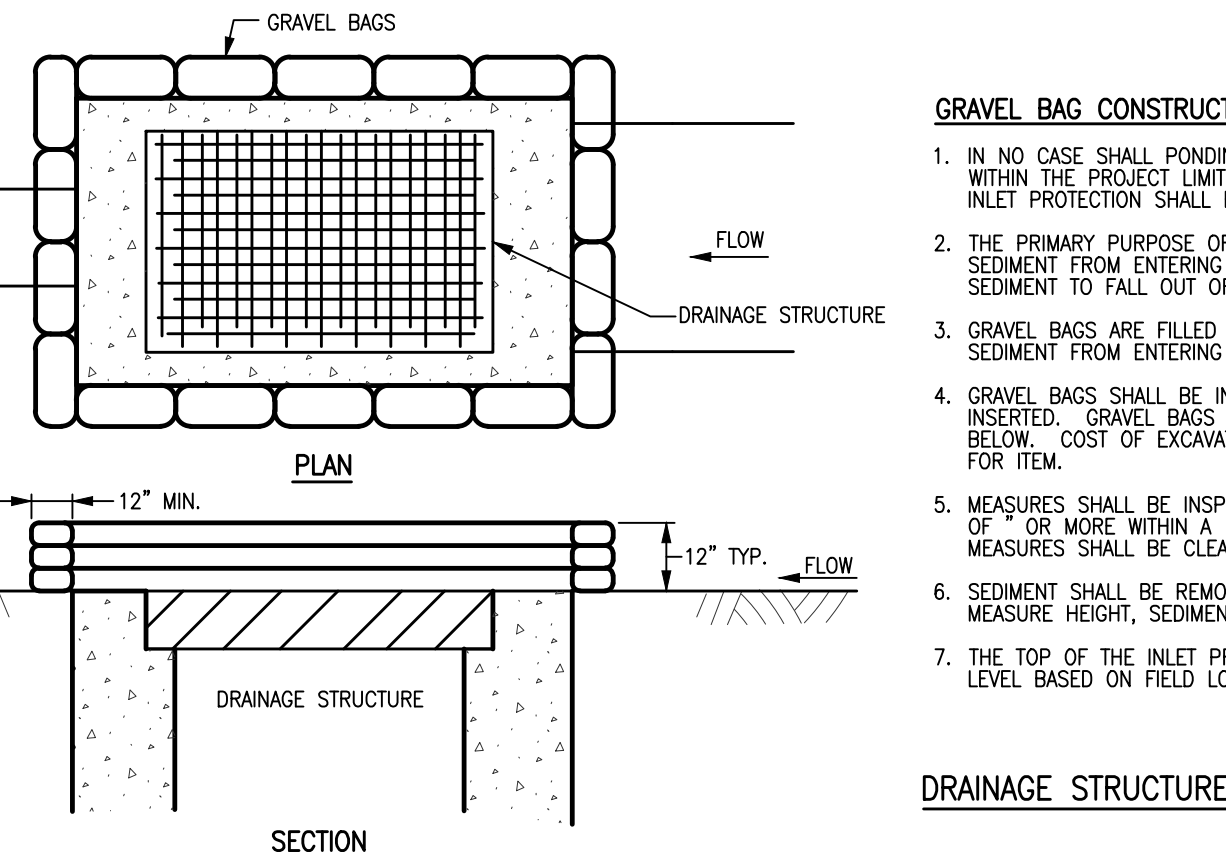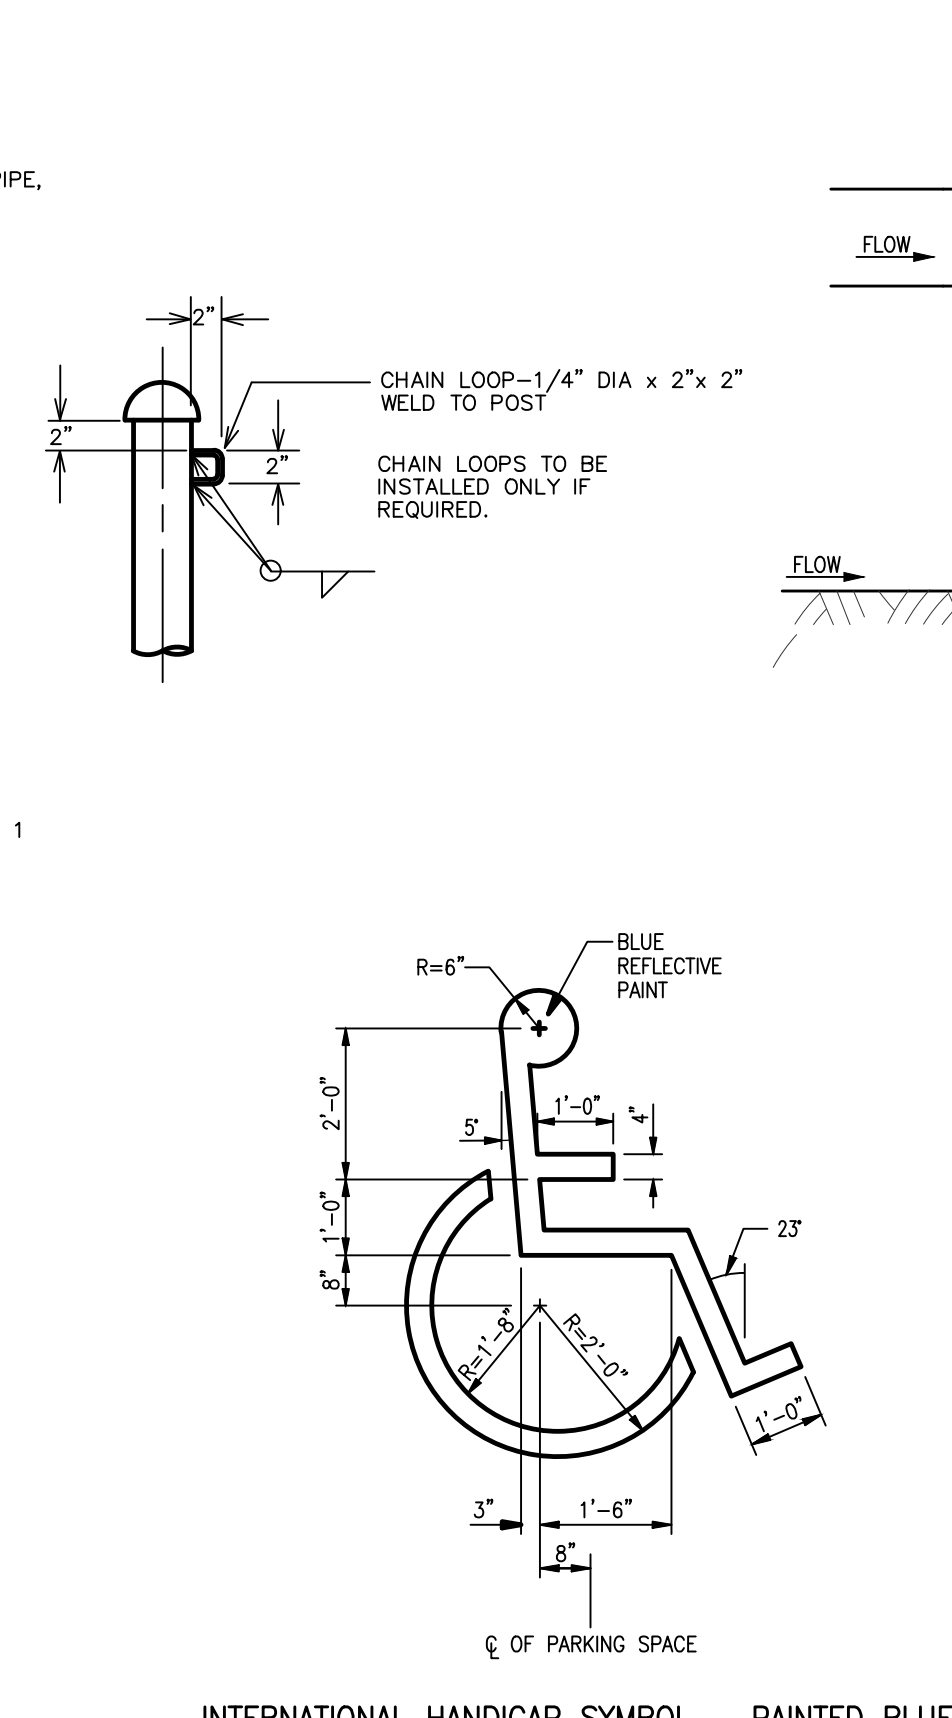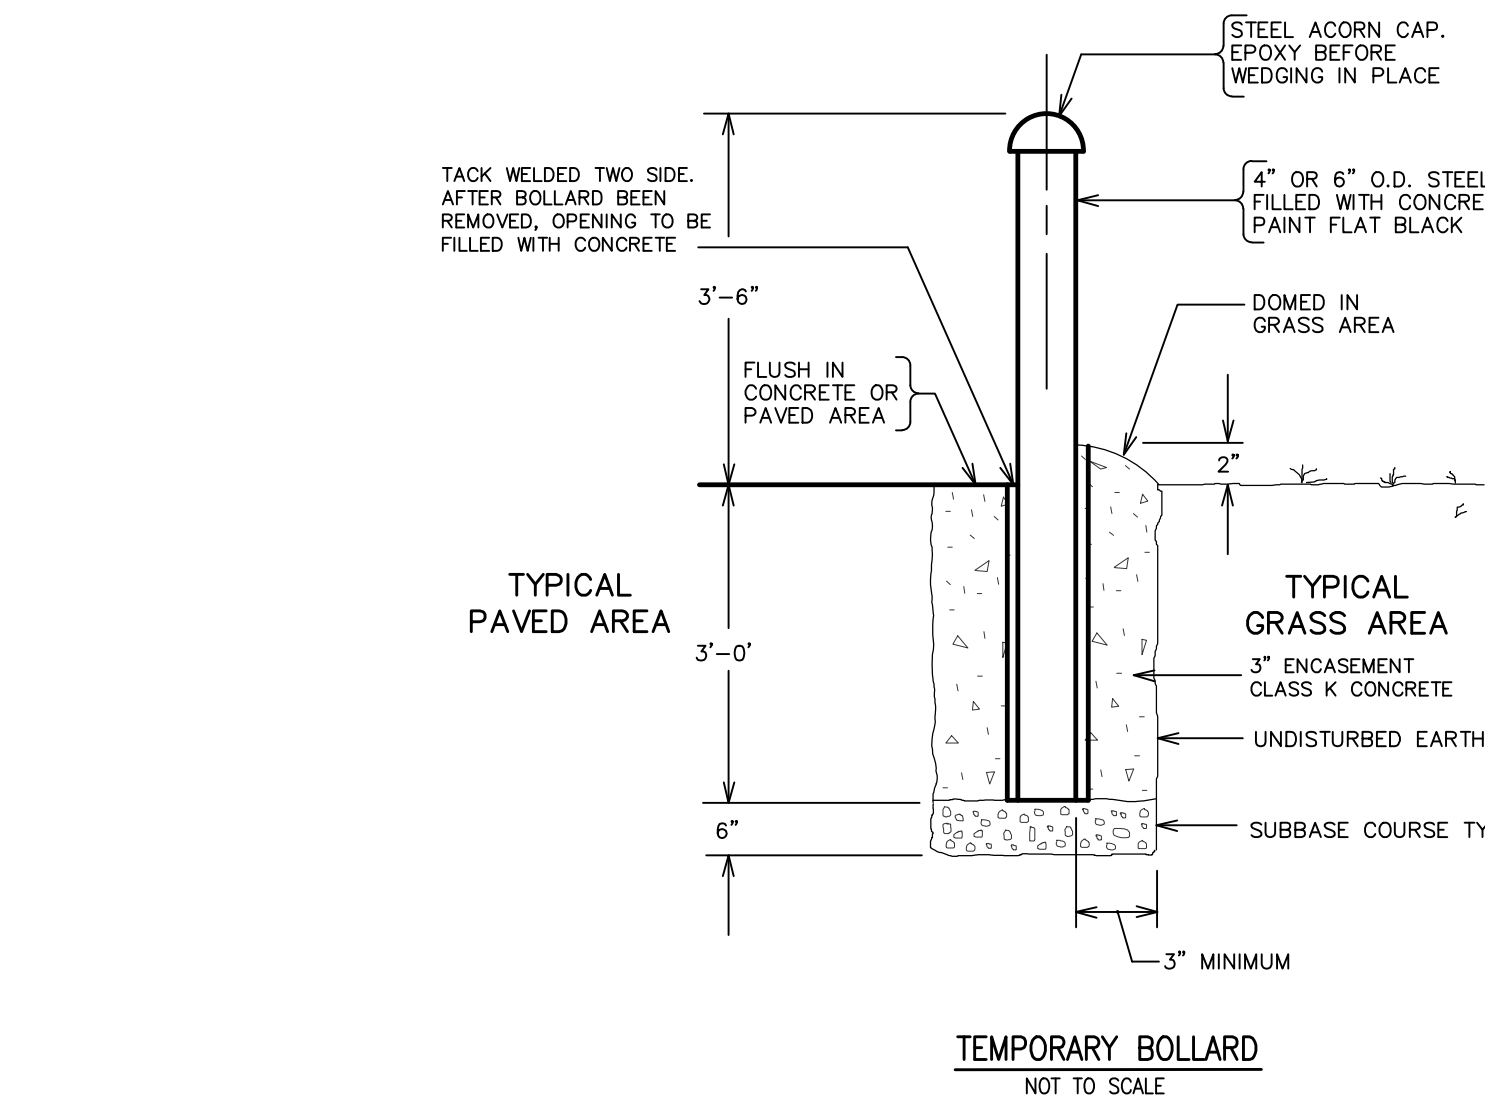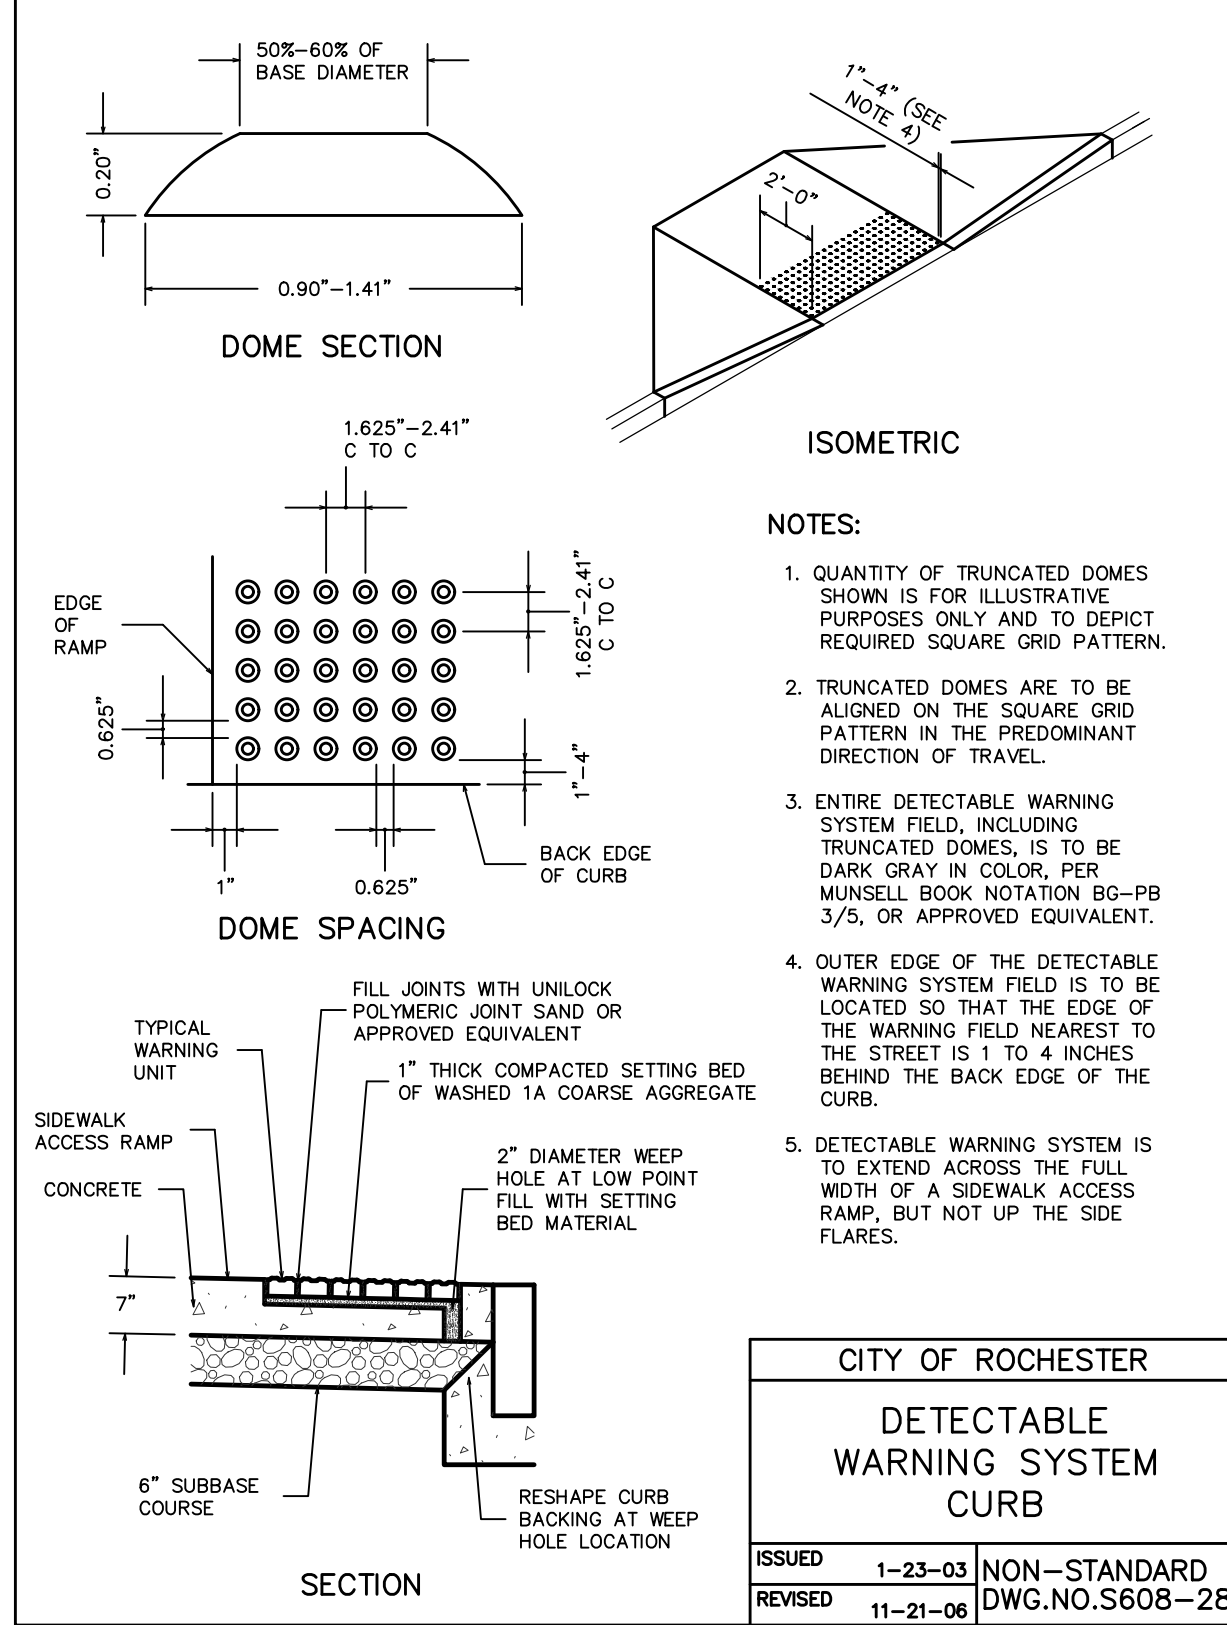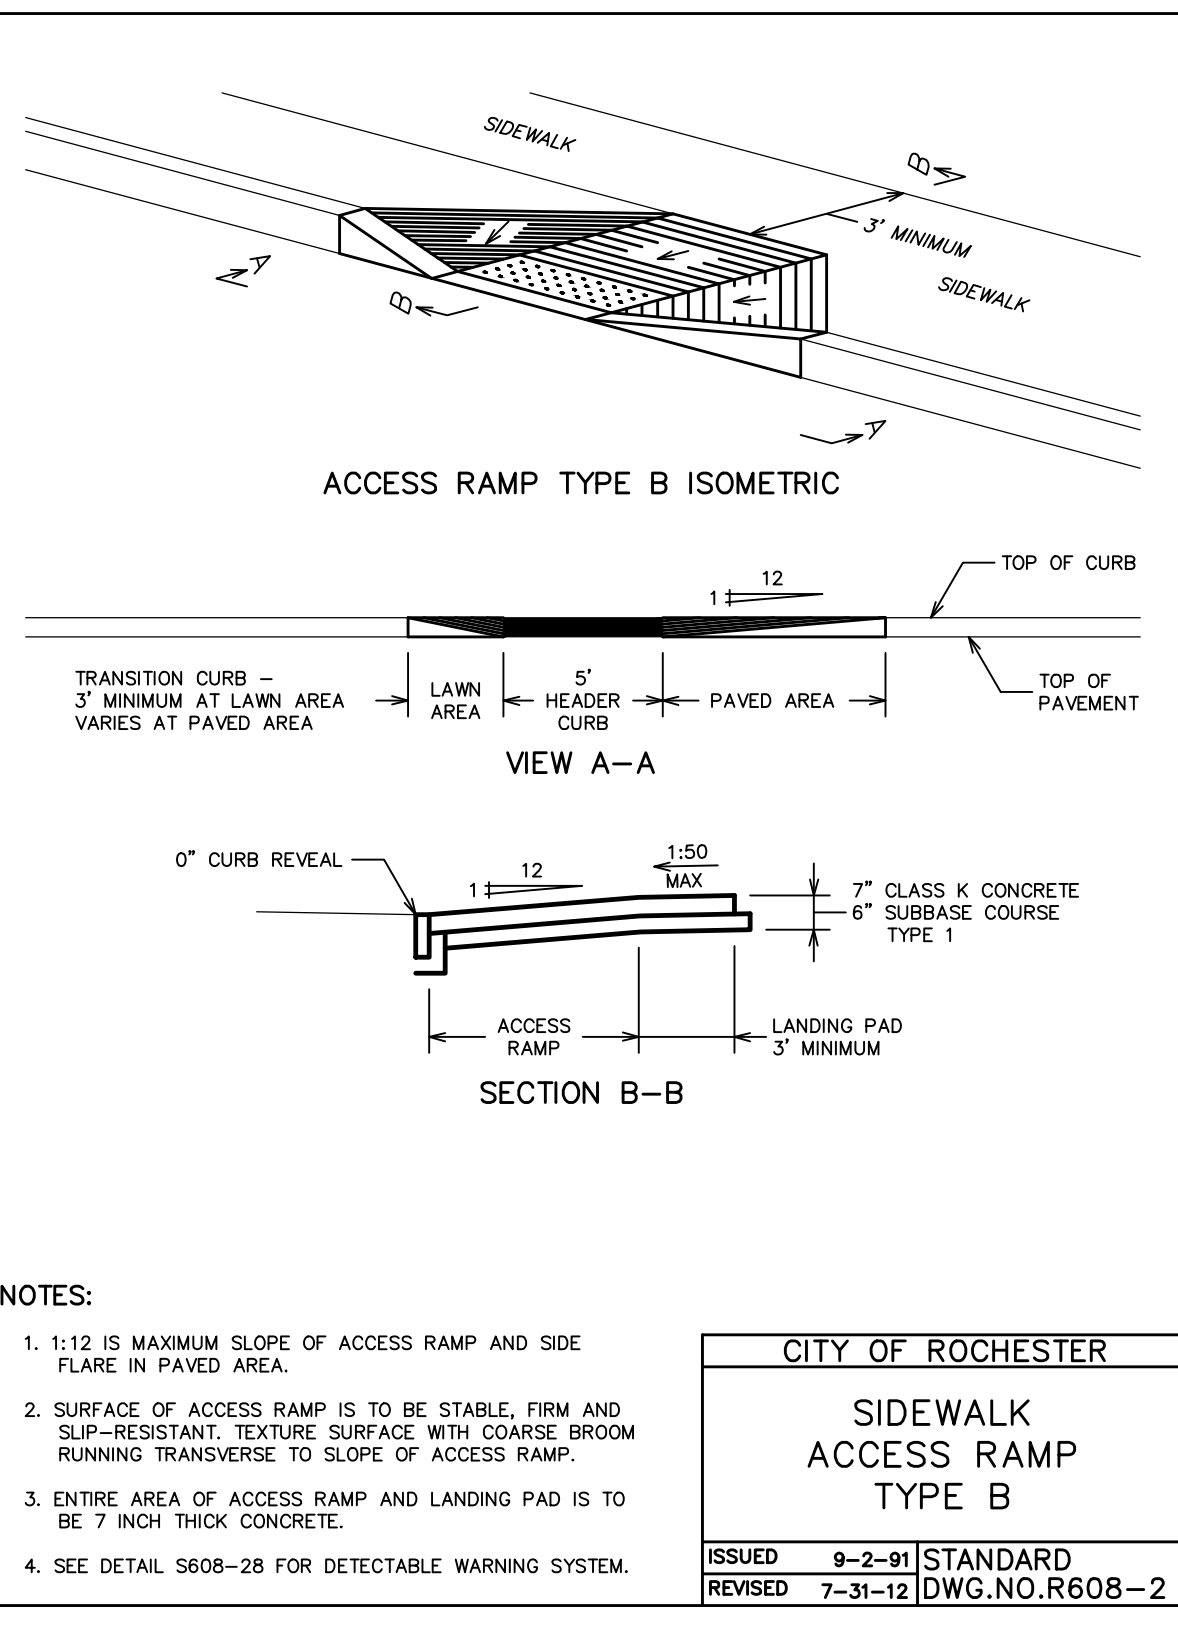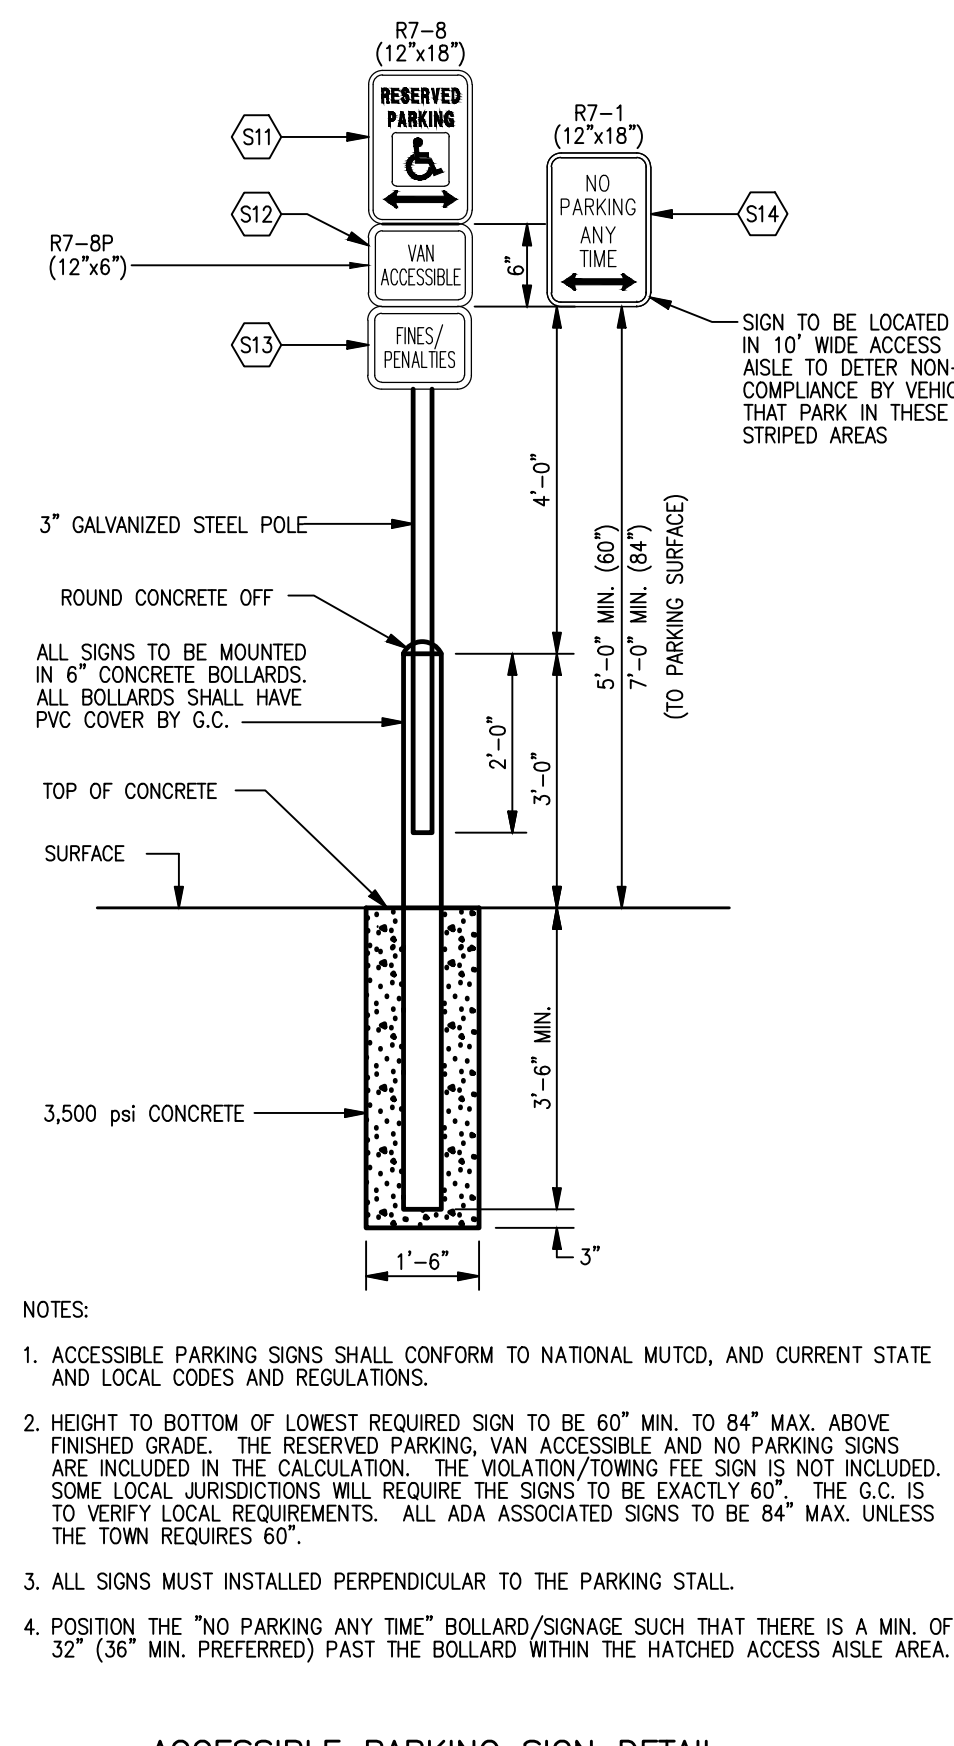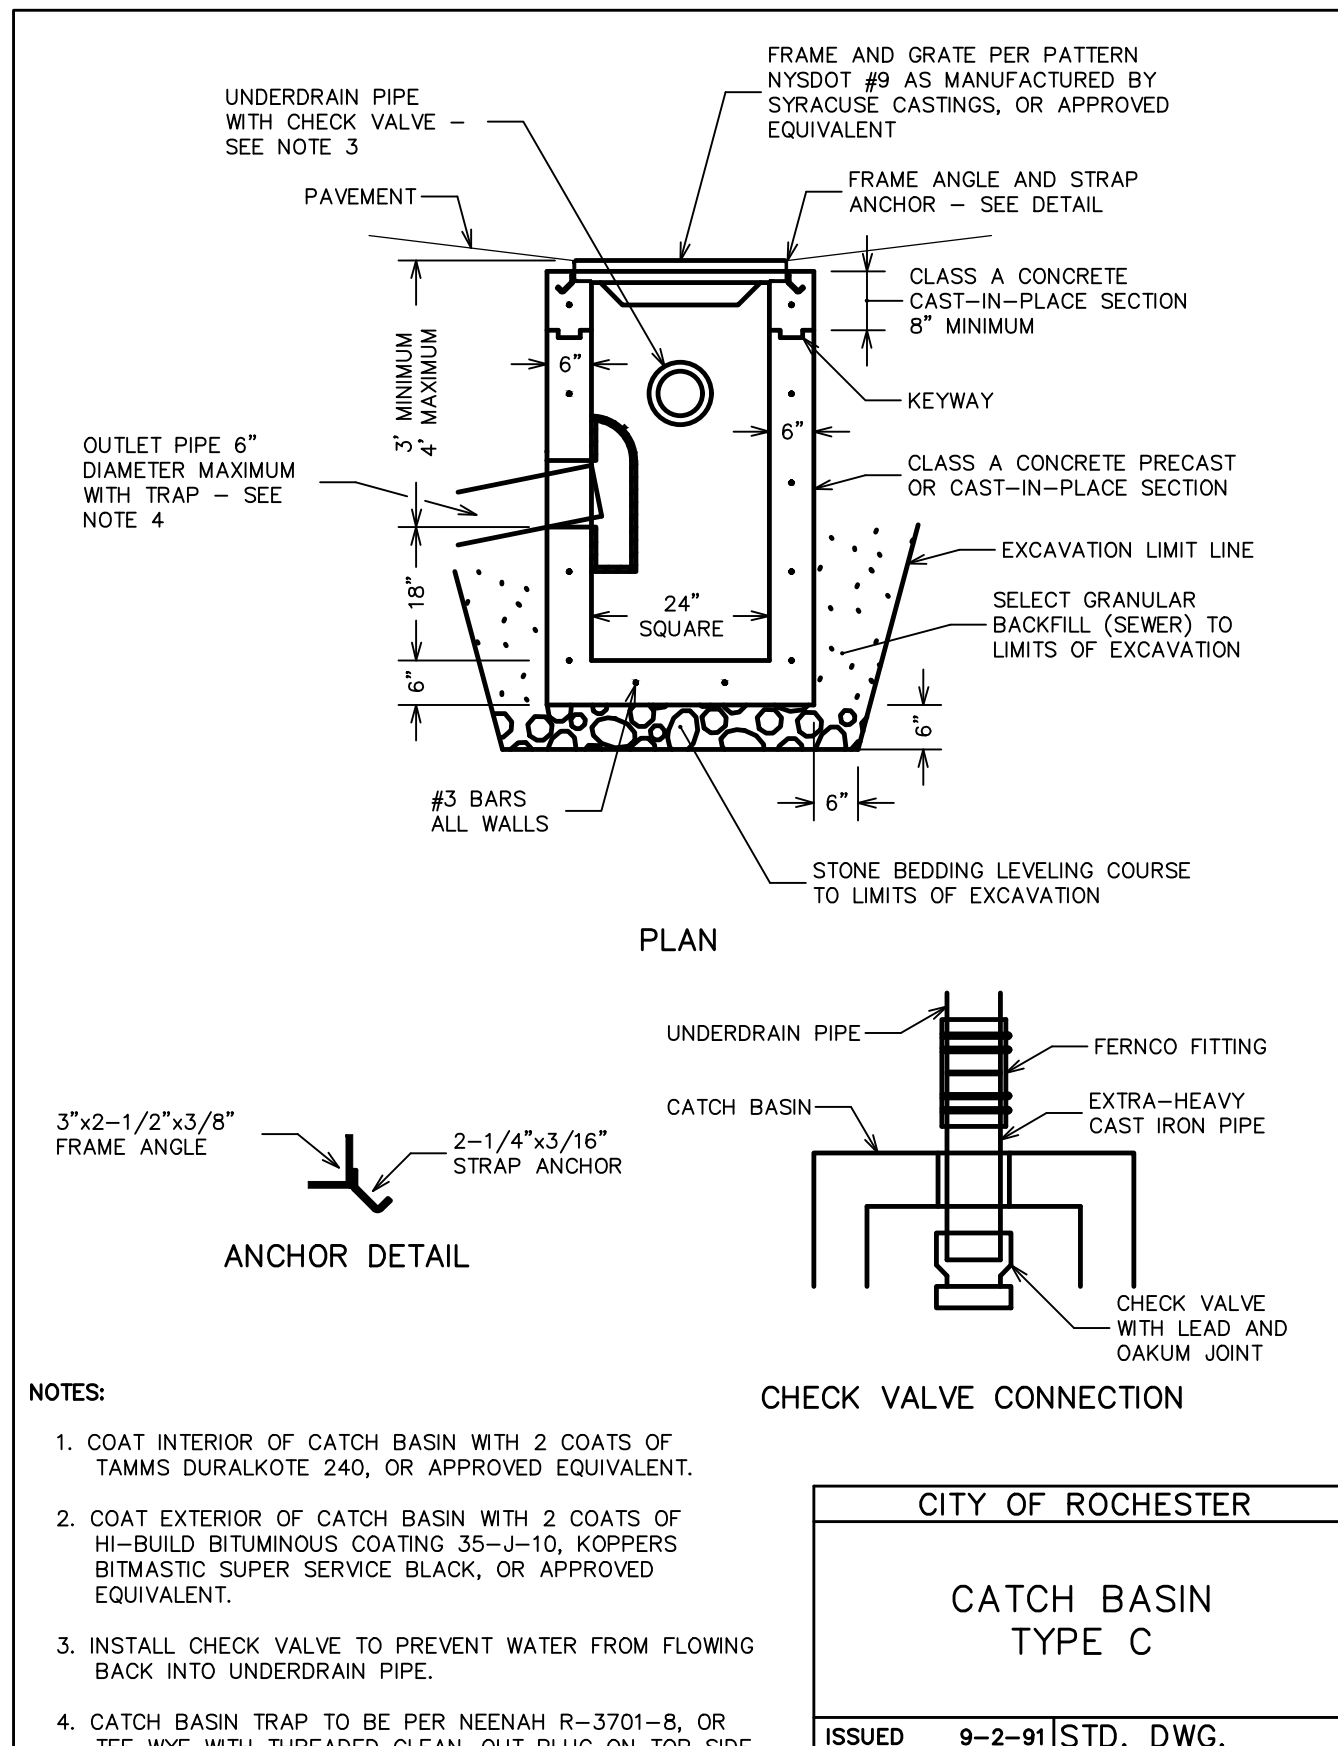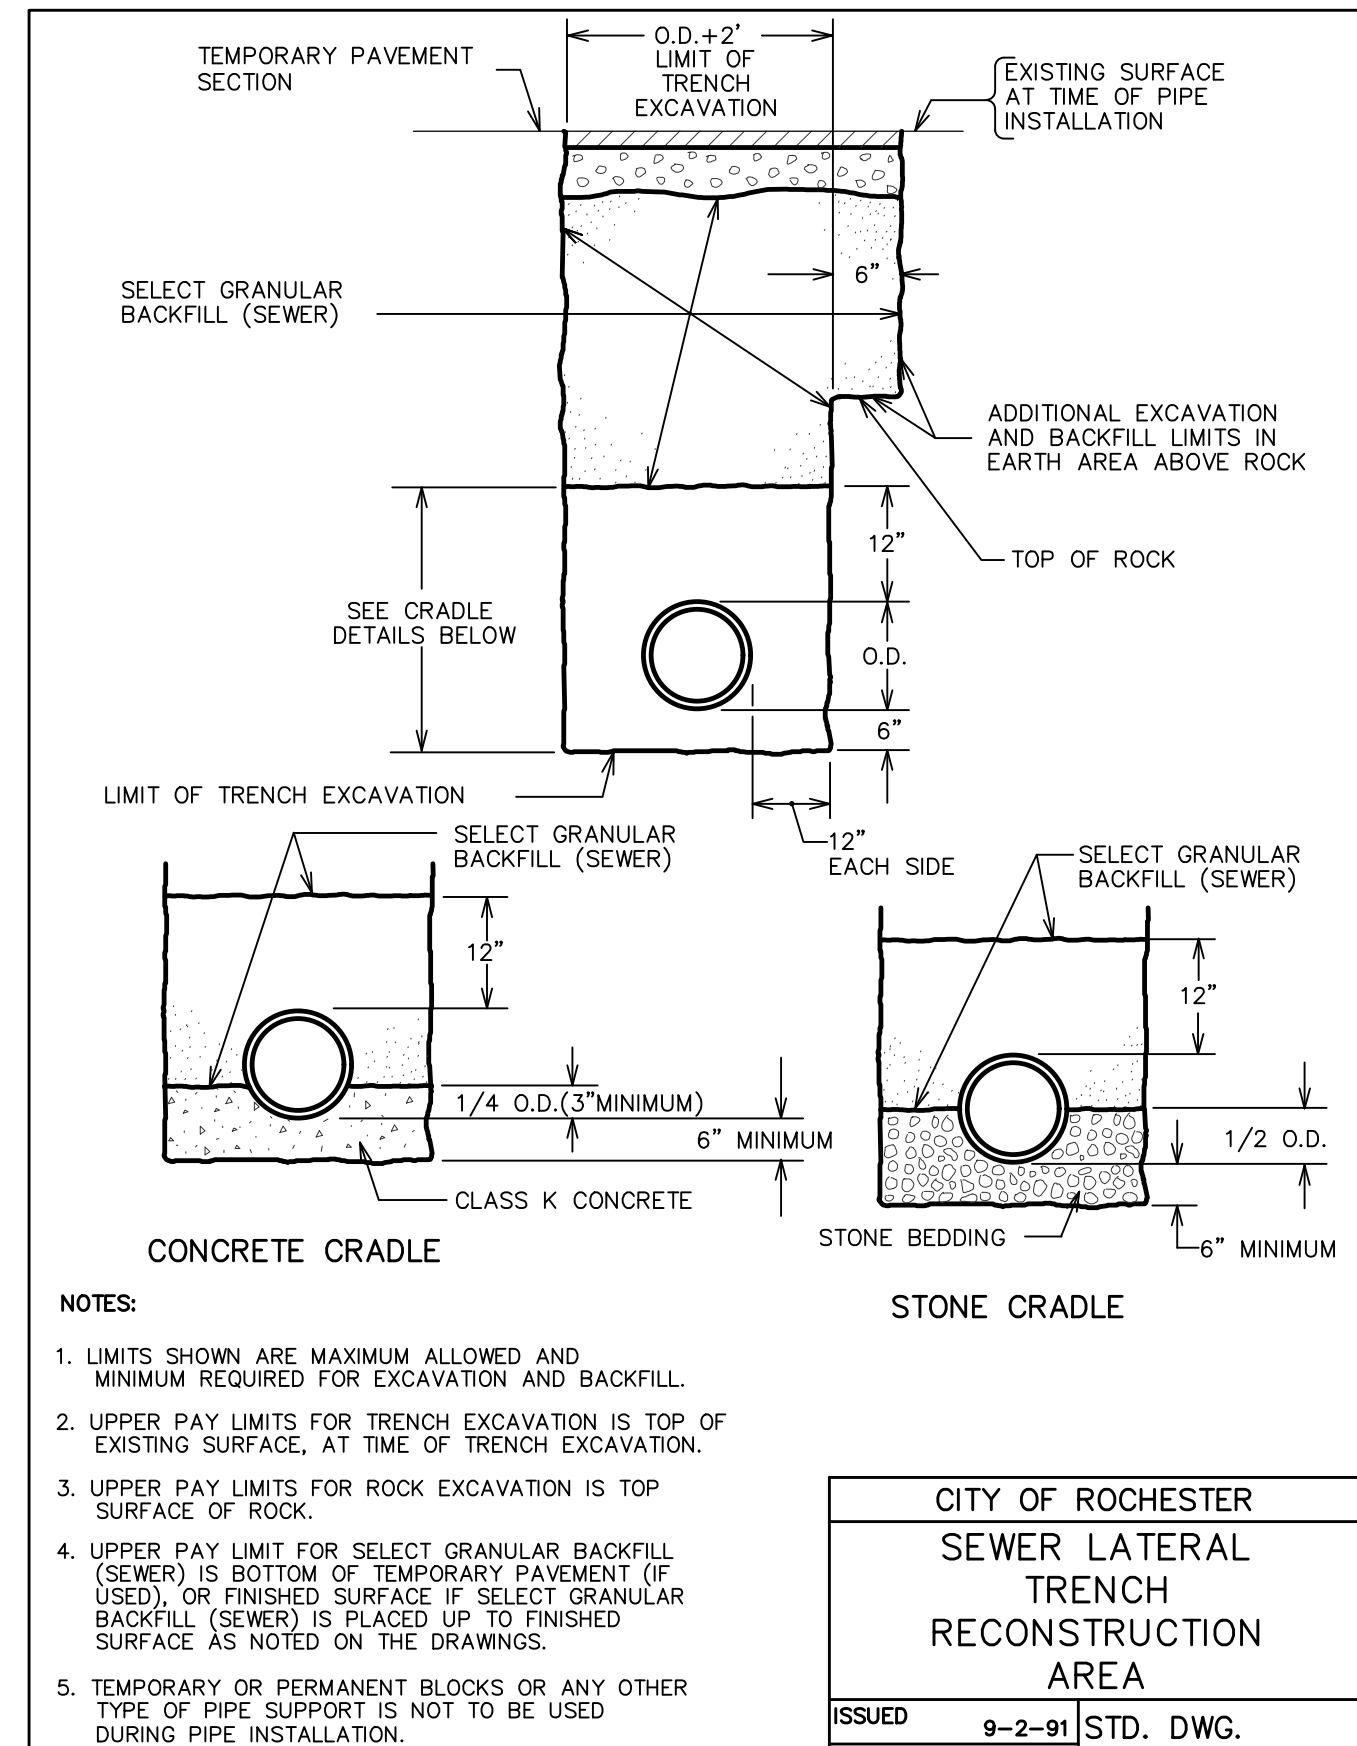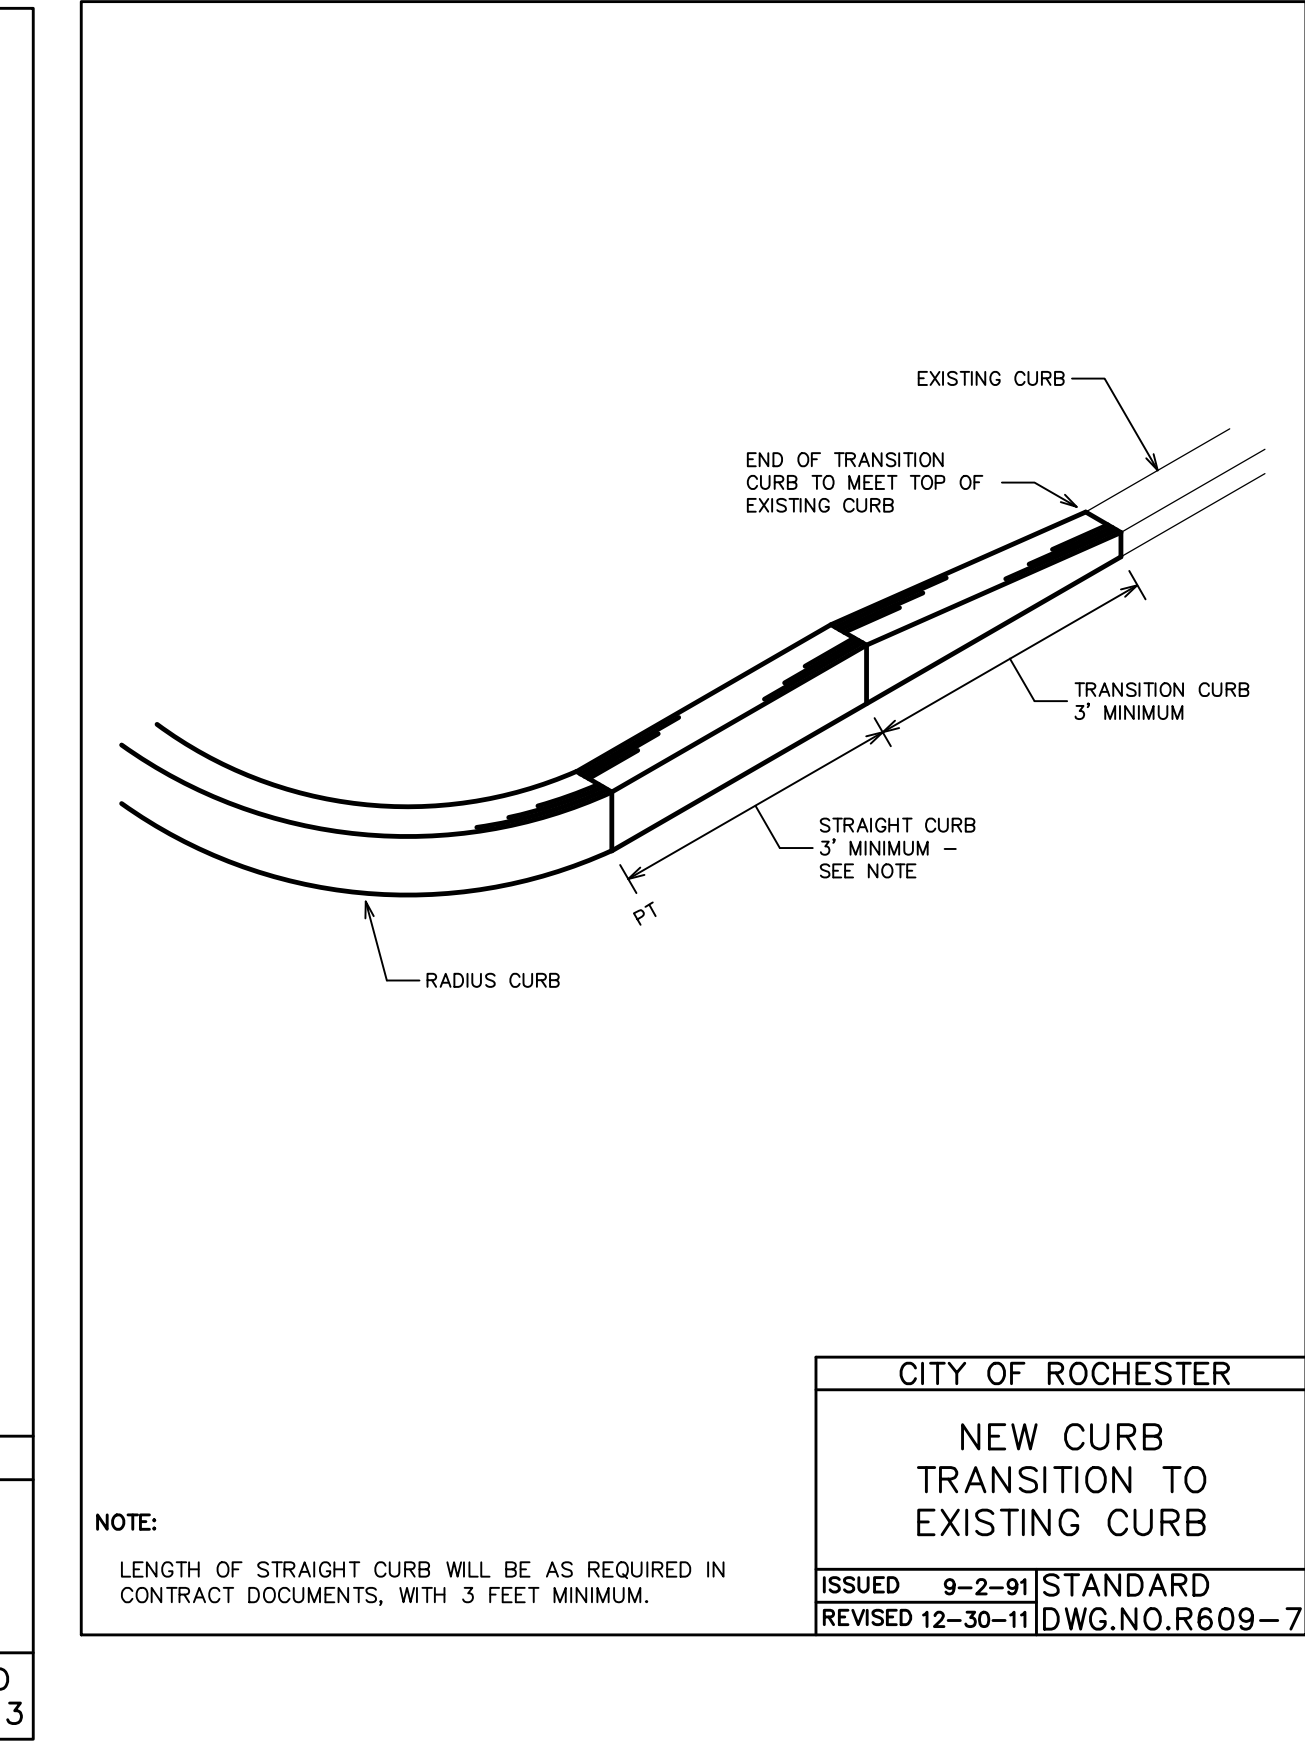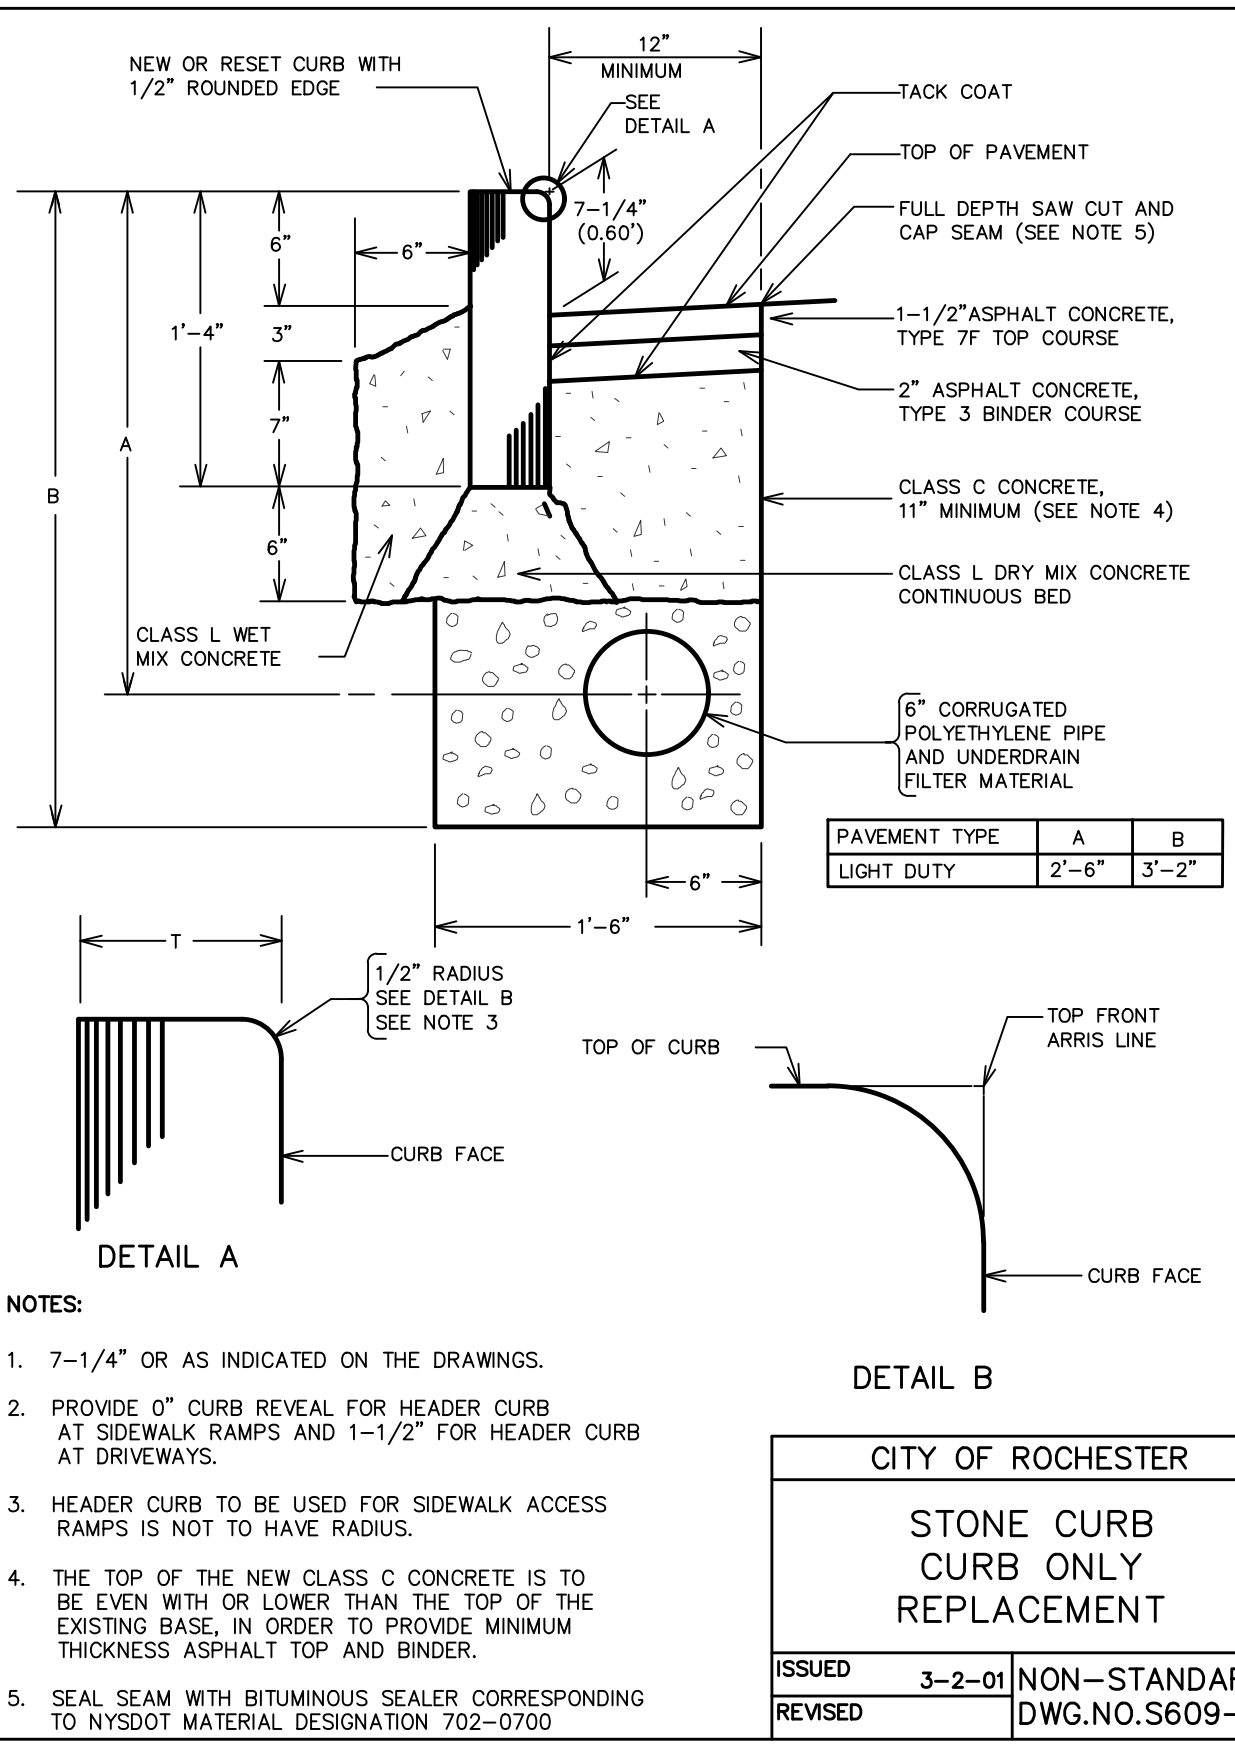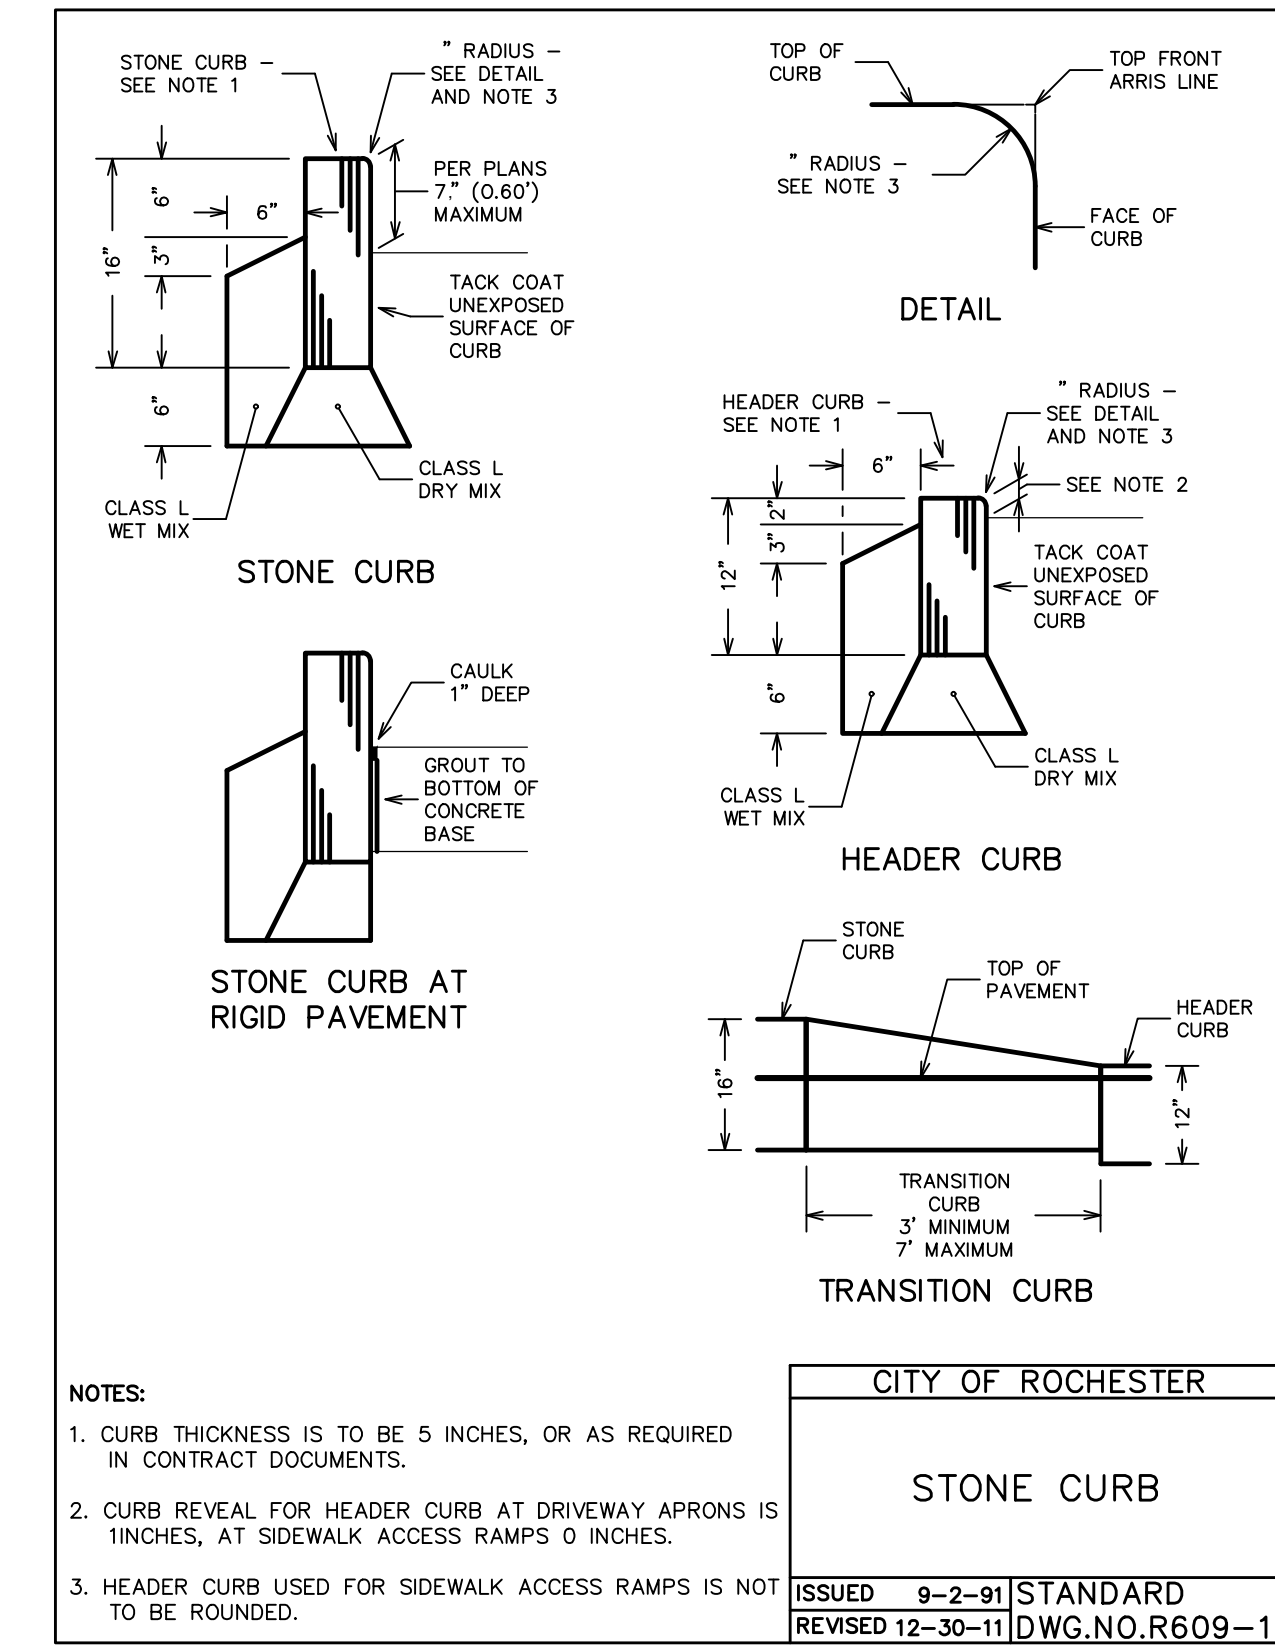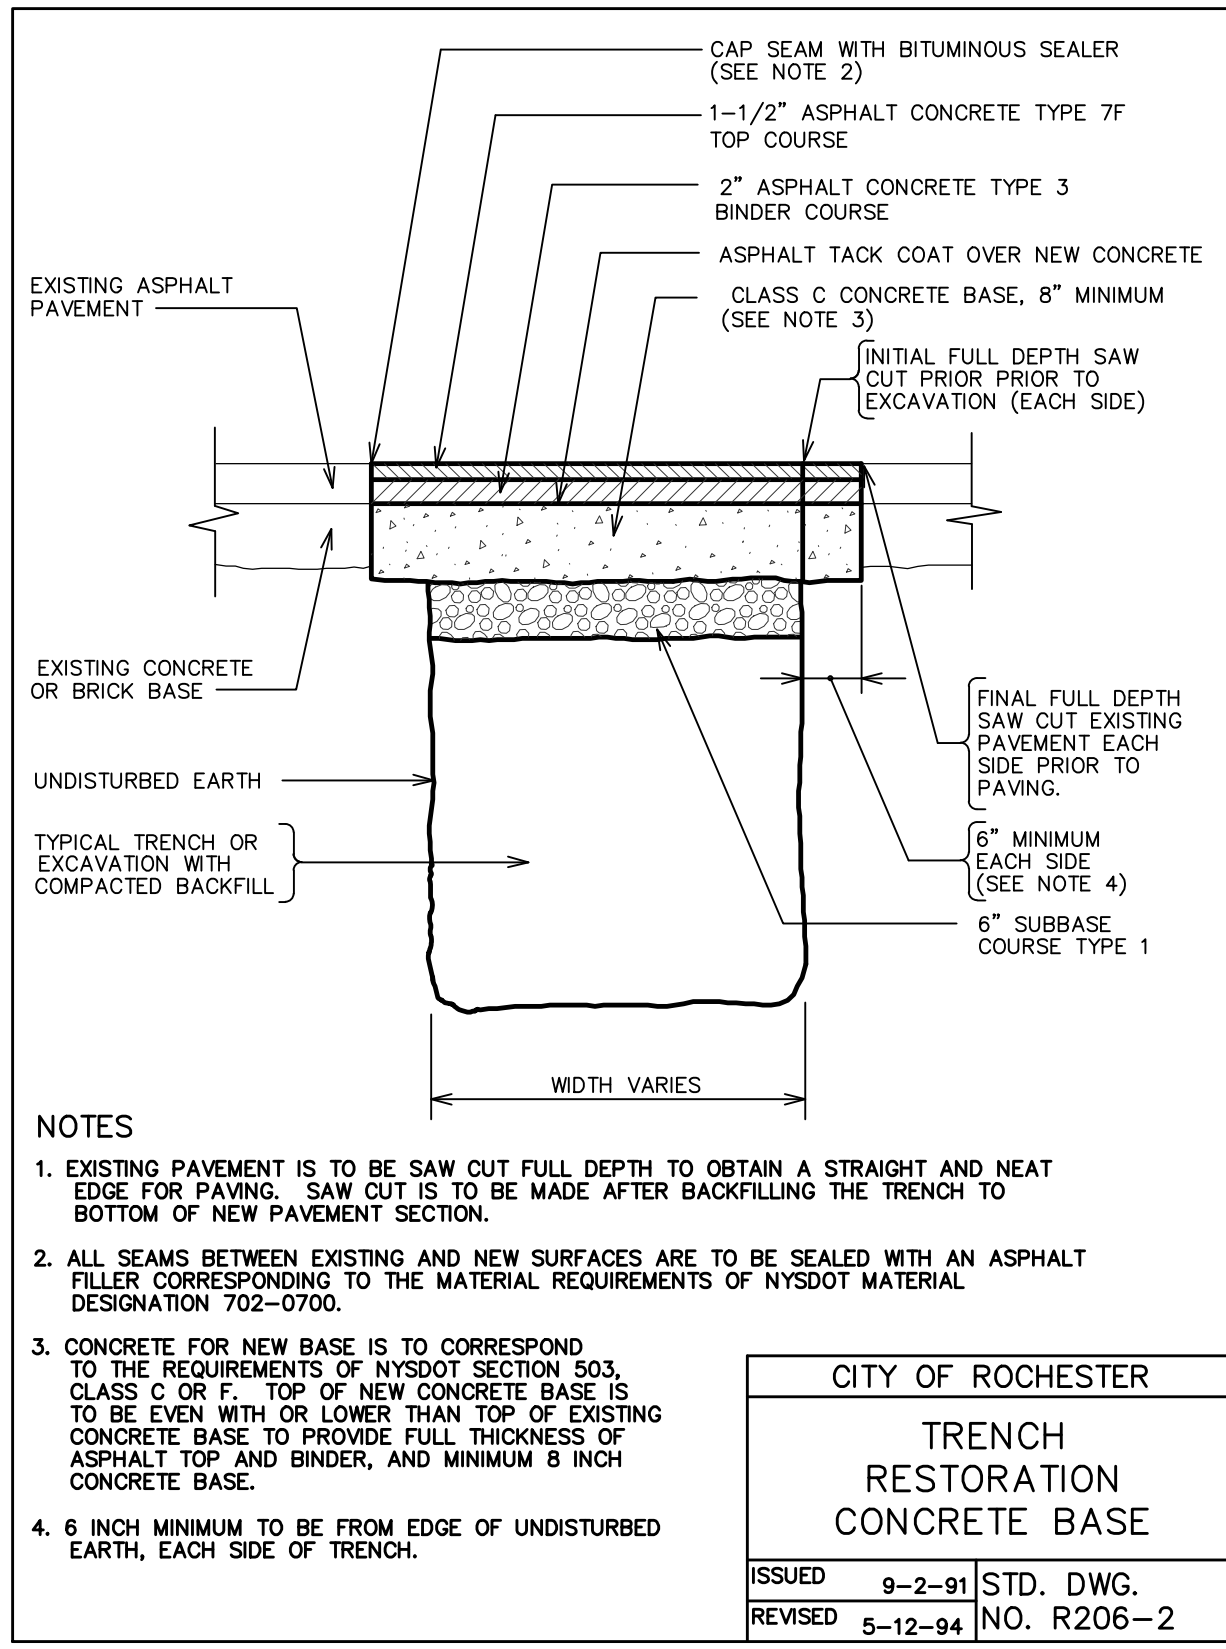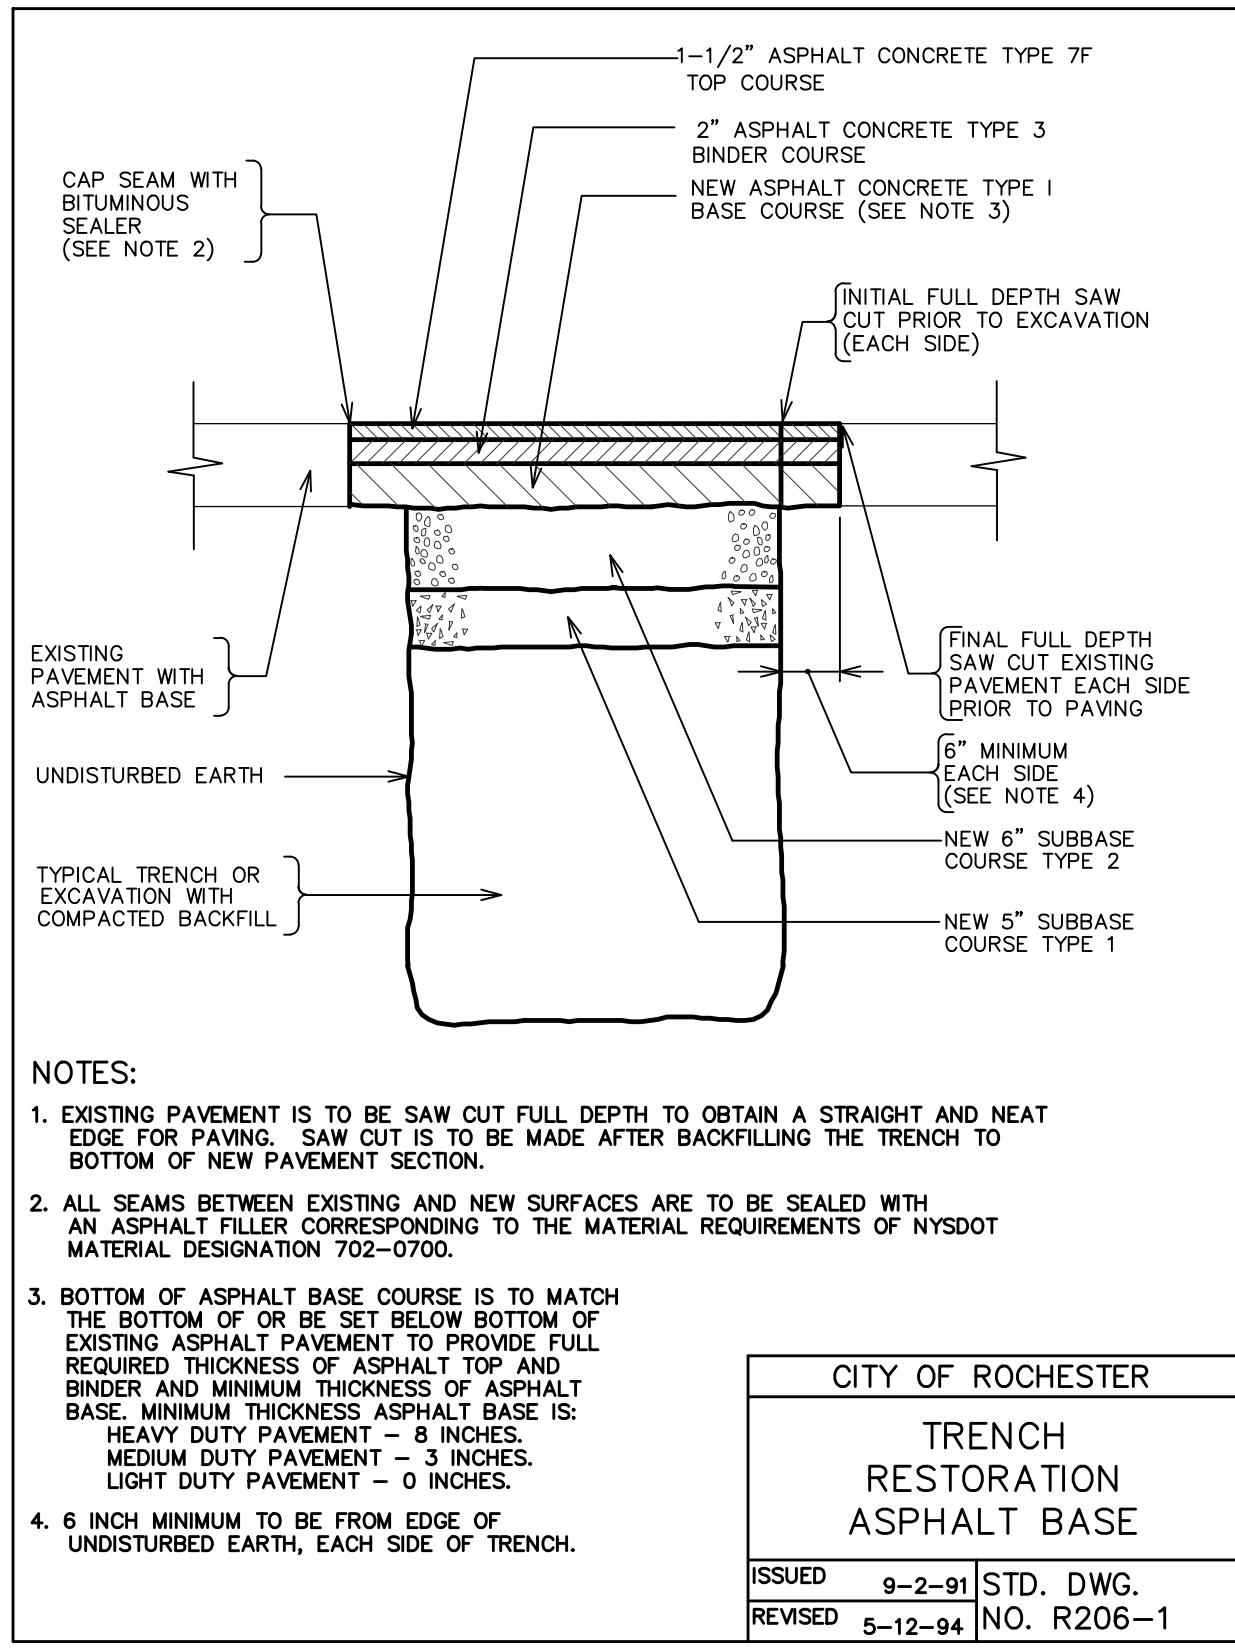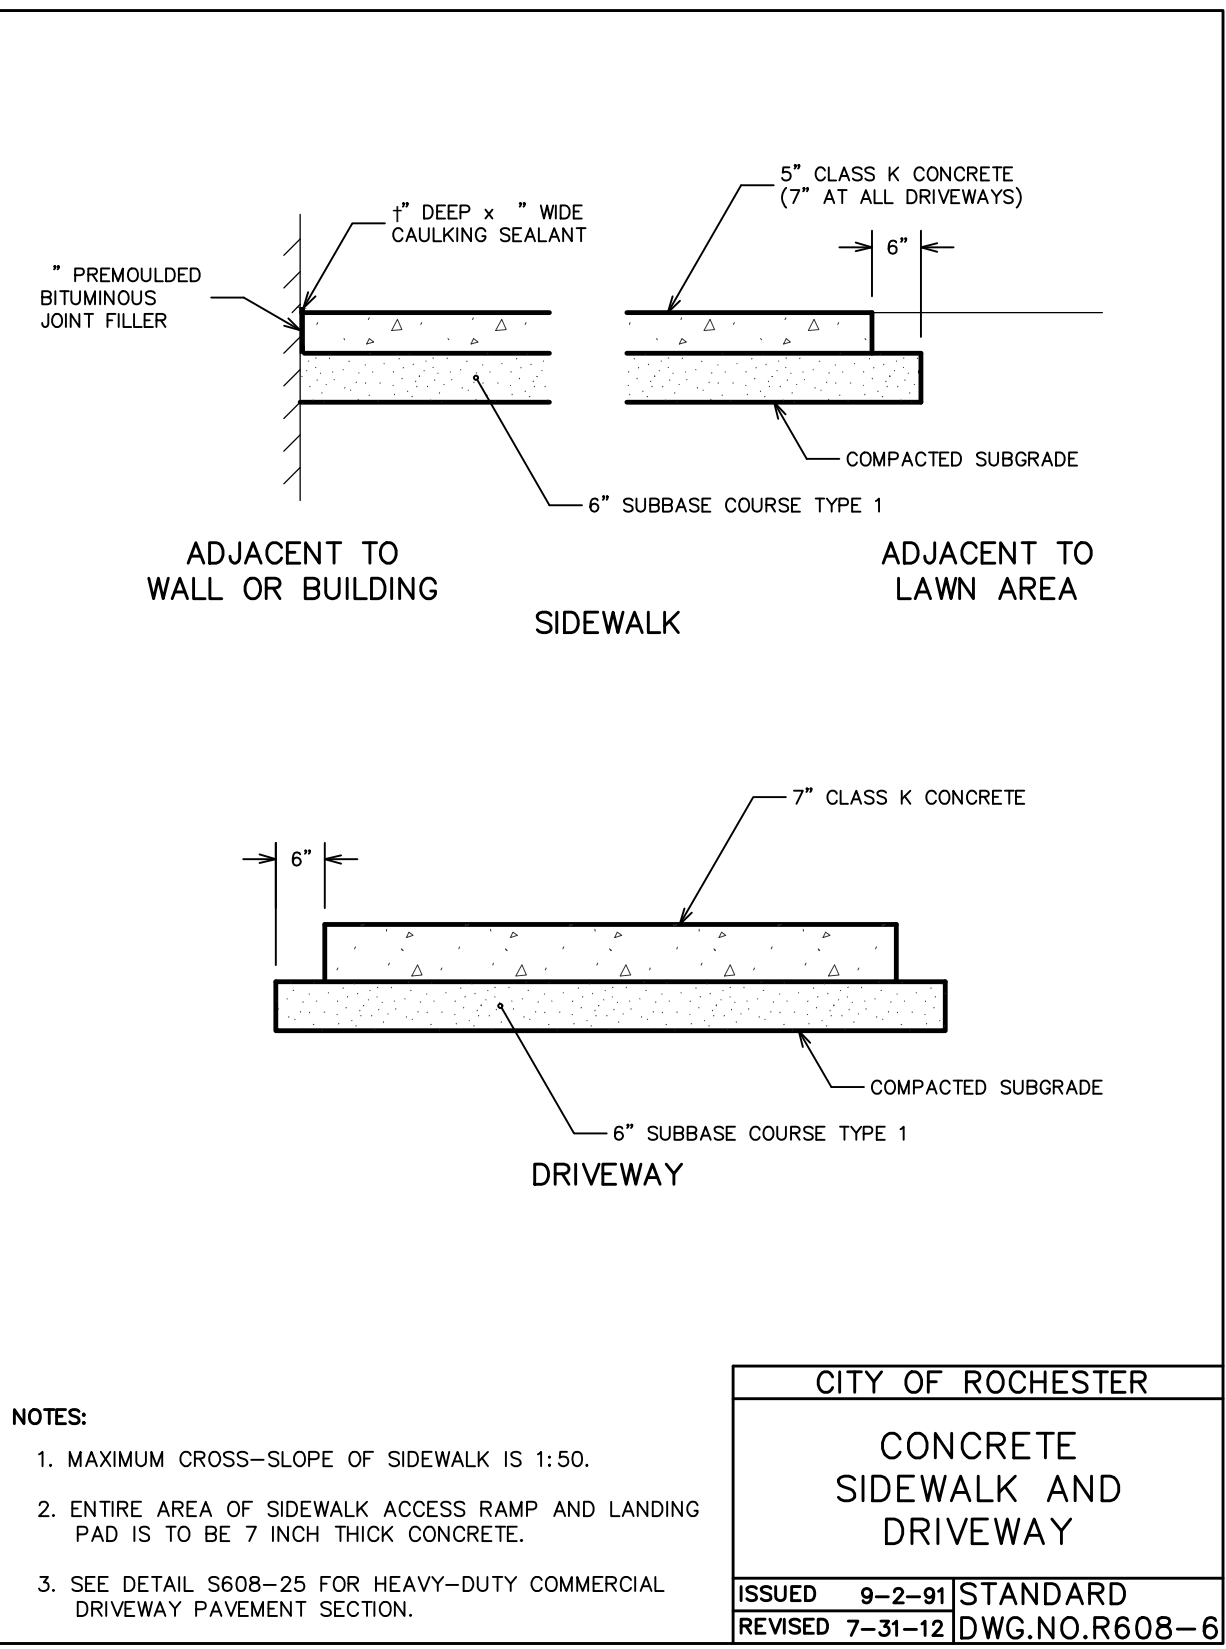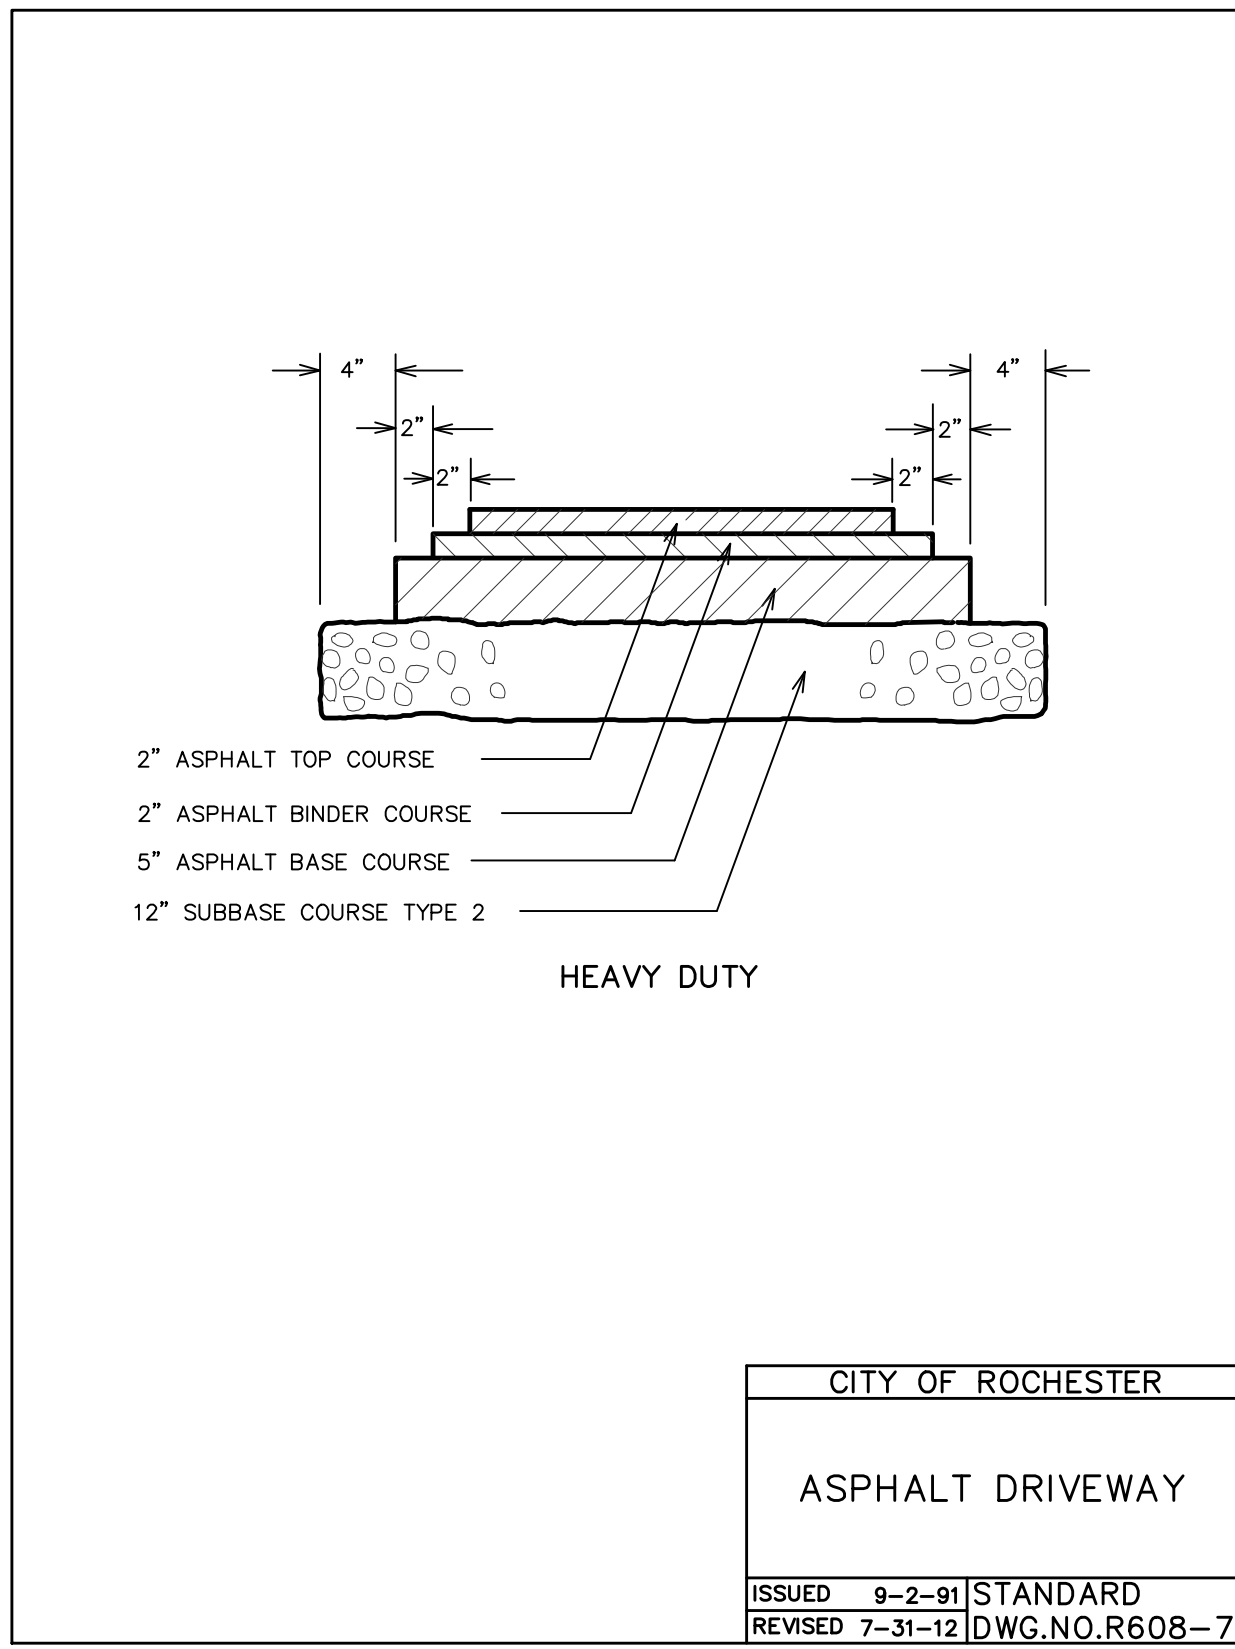

AS-BUILT DRAWINGS

UNAUTHORIZED ALTERATION OR ADDITION TO THIS DRAWING IS A VIOLATION OF NEW YORK STATE EDUCATION LAW ARTICLE 143, SECTION 7209

NO.	DATE	DESCRIPTION	REVISIONS
1			

05/16/18

DATE

TYLINTNATIONAL

255 EAST AVENUE
ROCHESTER, NY 14604
(585) 512-2000

CONSTRUCTION DETAILS-1

SHED D AND TEMPORARY KIOSK LOCATIONS

PROJECT NAME: ROCHESTER PUBLIC MARKET

CLIENT: ROCHESTER PUBLIC MARKET

30 Church Street, Rochester, NY 14614

PROJECT NO.: 435346.01

PROJ. MGR. THC

DATE: 5/16/18

DRWN. BY: JV

SCALE: AS NOTED

CHKD. BY: RLB

DRAWING NO. DC201

SHEET NO. 11 of 73

